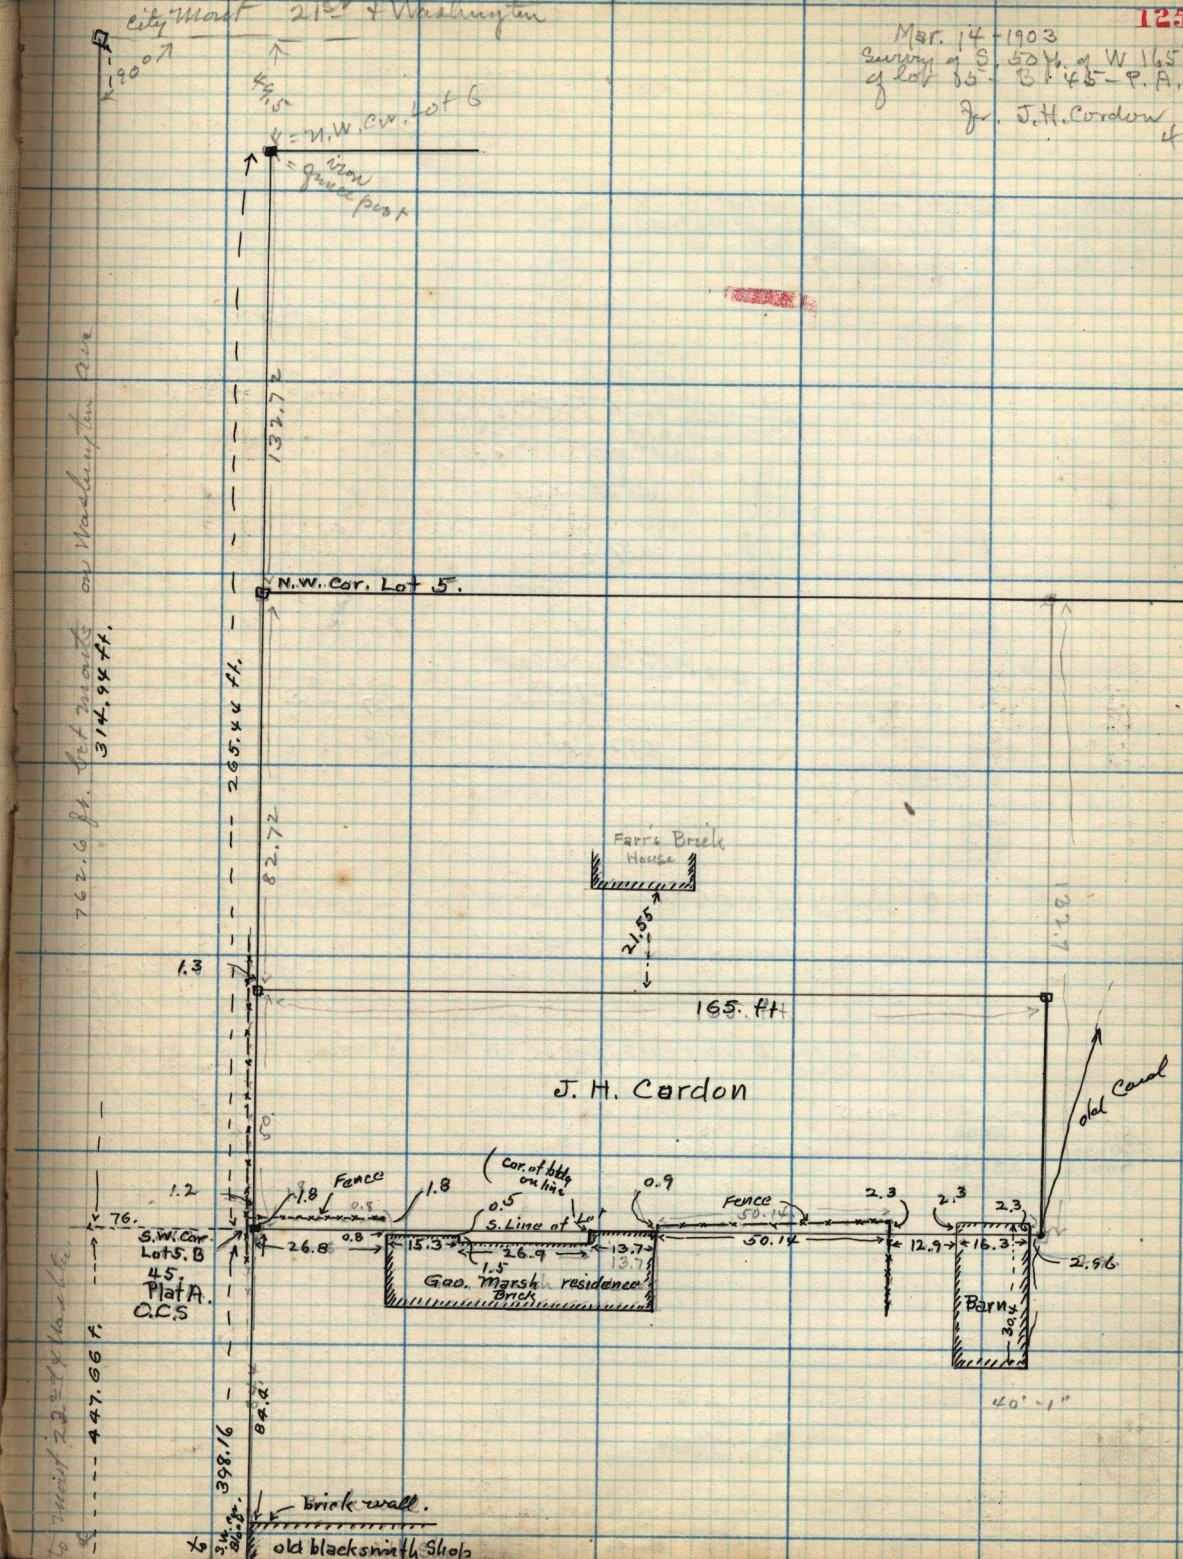Mar. 14-1903
Survey of S. 50 ft. of W 165 ft of Lot 55 - Bl. 45 - P. A.
for J. H. Cordon