


March 19-1903
Survey of Land in Sec 8 19. T. 6 N. R. 1. W.
for Sharp and Rob Cowan.

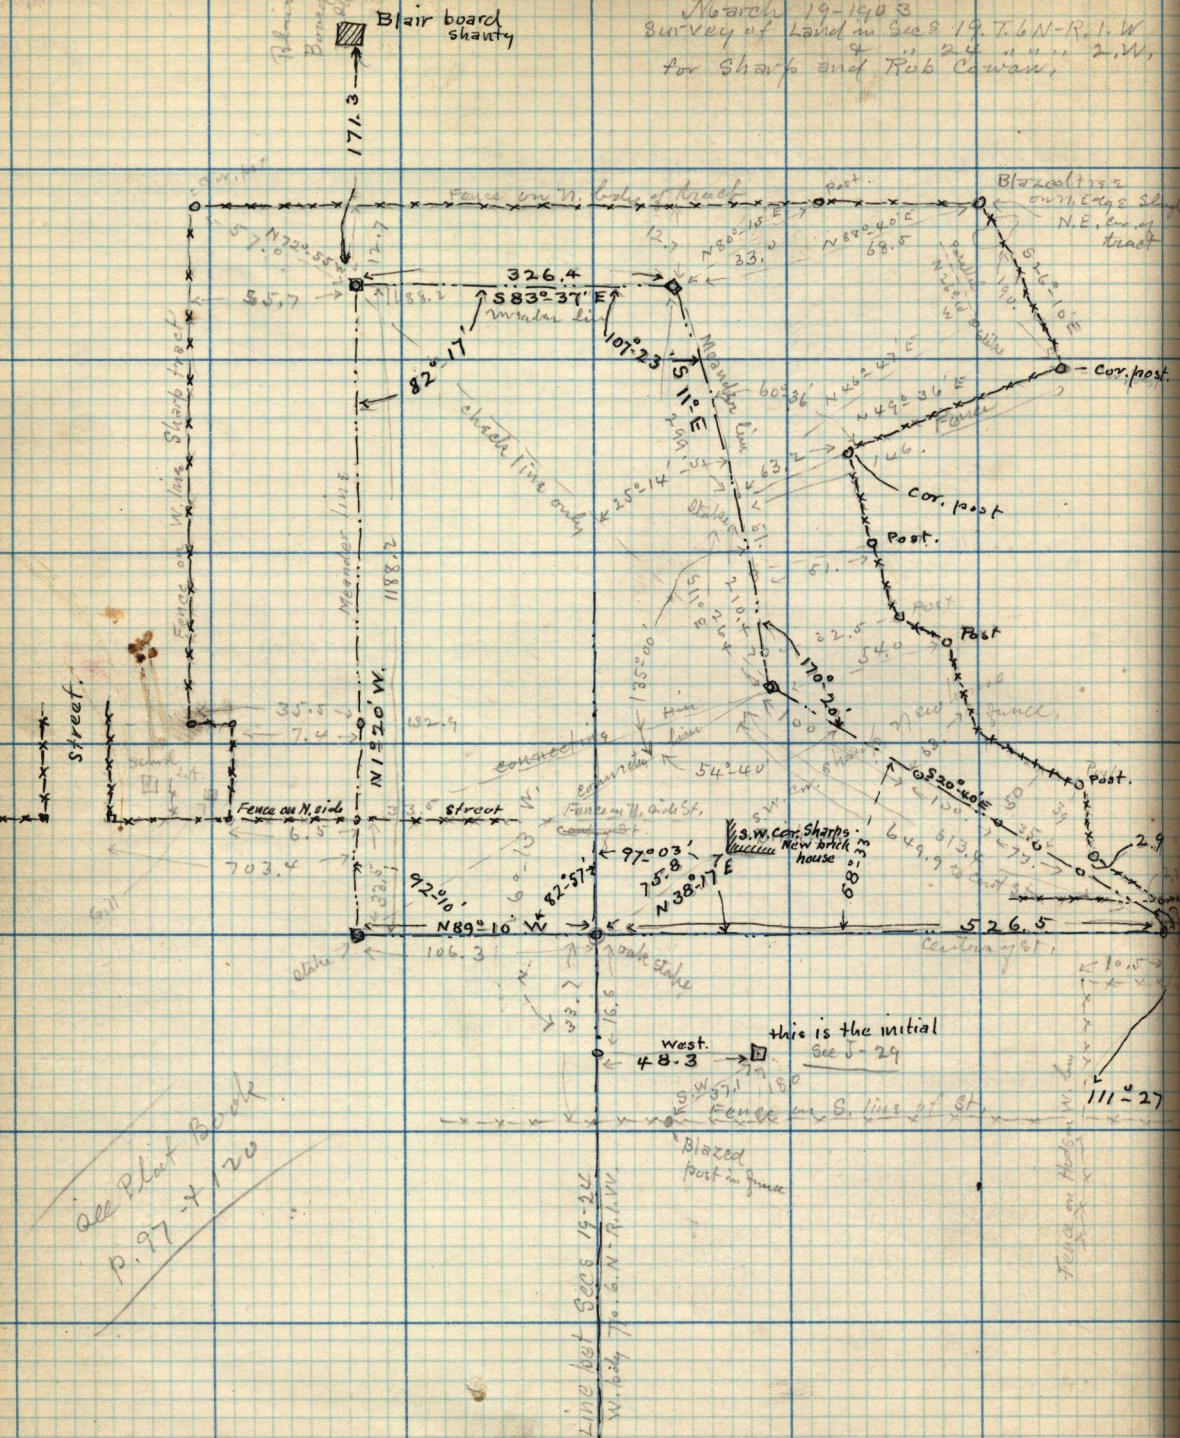

all Plat Book
P. 97 + 120

Line bet Sec 8 19-20
W. 624 70. 6. N. R. 1. W.

this is the initial
See J. 29

Blazed
post in fence

111-27