


S.W. cor. Hamilton's Lane

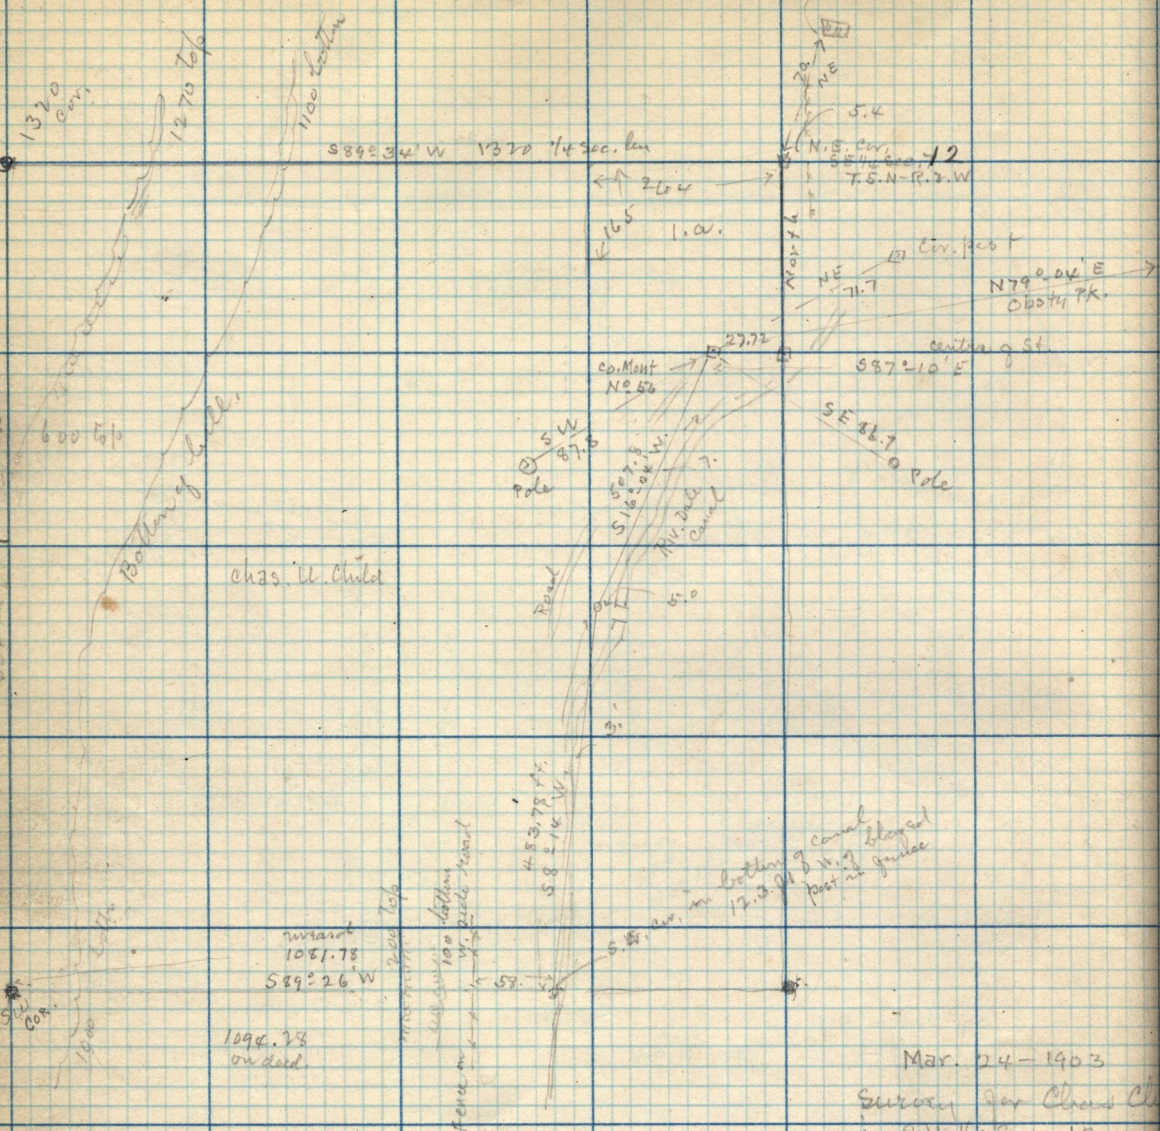

981  
 651  
 1542  
 981  
 290  
 490  
 290