



Apr. 11-1903 -  
Survey of Lots in B-G,  
Orchard Grove Add.

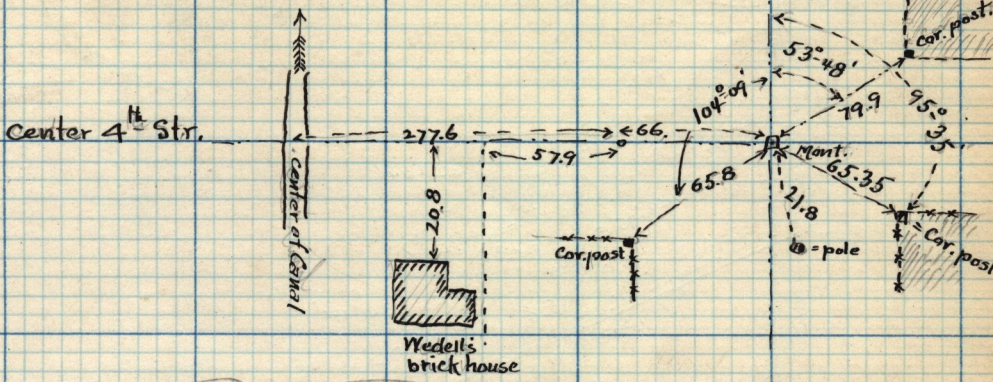

April 26-1903  
Survey of part of Lot 26,  
Block 7, Orchard  
Grove Plat. A. D.C.S.  
for Stump Chase and  
Hogan Chase

and from E.W. Chase  
to

Wm H Chase  
PL Lot 26 - B7.50 ac.  
N.W. 1/4, 0.07 ch. N.W. 1/4 S.E. 1/4  
S.W. 1/4 - W. 1/4 7.32 ch.  
N. 1/2 ch. E. 1/4 7.32 ch.  
S. 1/4 ch. to E.W.

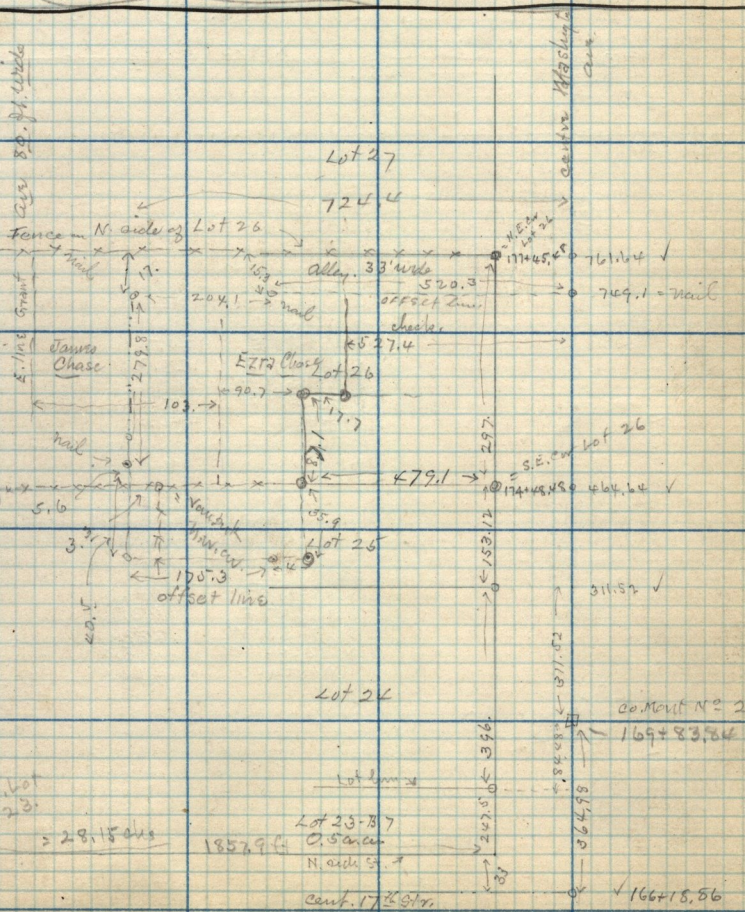

82.5

26.9

S.W. corner Lot 23

28.15 chs

1857.9





