


35  
500

copy, deed from C. Ingebratsen to P. M. Paulsen - Beg. 7 rods W. =  
12 1/2 rods N. from the S.E. Cor. Lot 2 B40. Plat A, O.C.S. - Running  
N 2 1/2 rods - Co. 7 Rods. S 2 1/2 Rods W. 7 Rods to Beg.


J. Stoddard & H. Shaw asst.

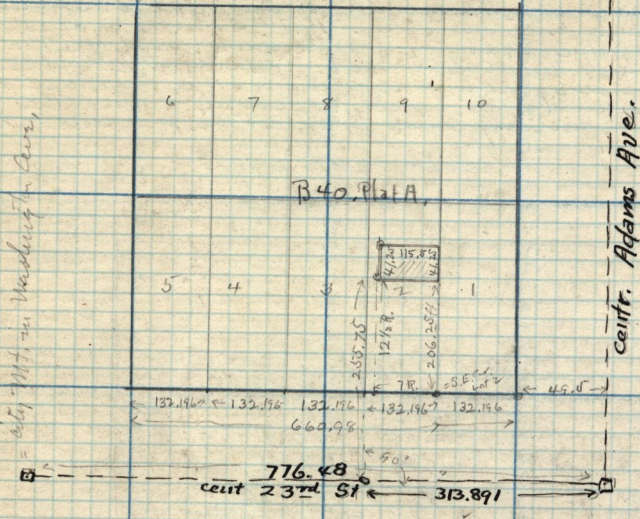

city Mt. Washington Ave.

cent. Adams Ave.

Mottet Lane  
W. line Lot 2  
41.20

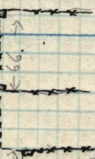

Fence  
Paulsen N.W. Cor. as surveyed  
by me.

S.W. cor. P. Paulsen

Shaw's retaining wall  
Fence

Mount Washington 23rd

313.89  
Cent 23rd St.

City Mount. cent Adams & 23rd St