July 18 - 1903 -
Survey for Chauncey Parry, in Sec. 20.
T. 6. N - R. 1. W.

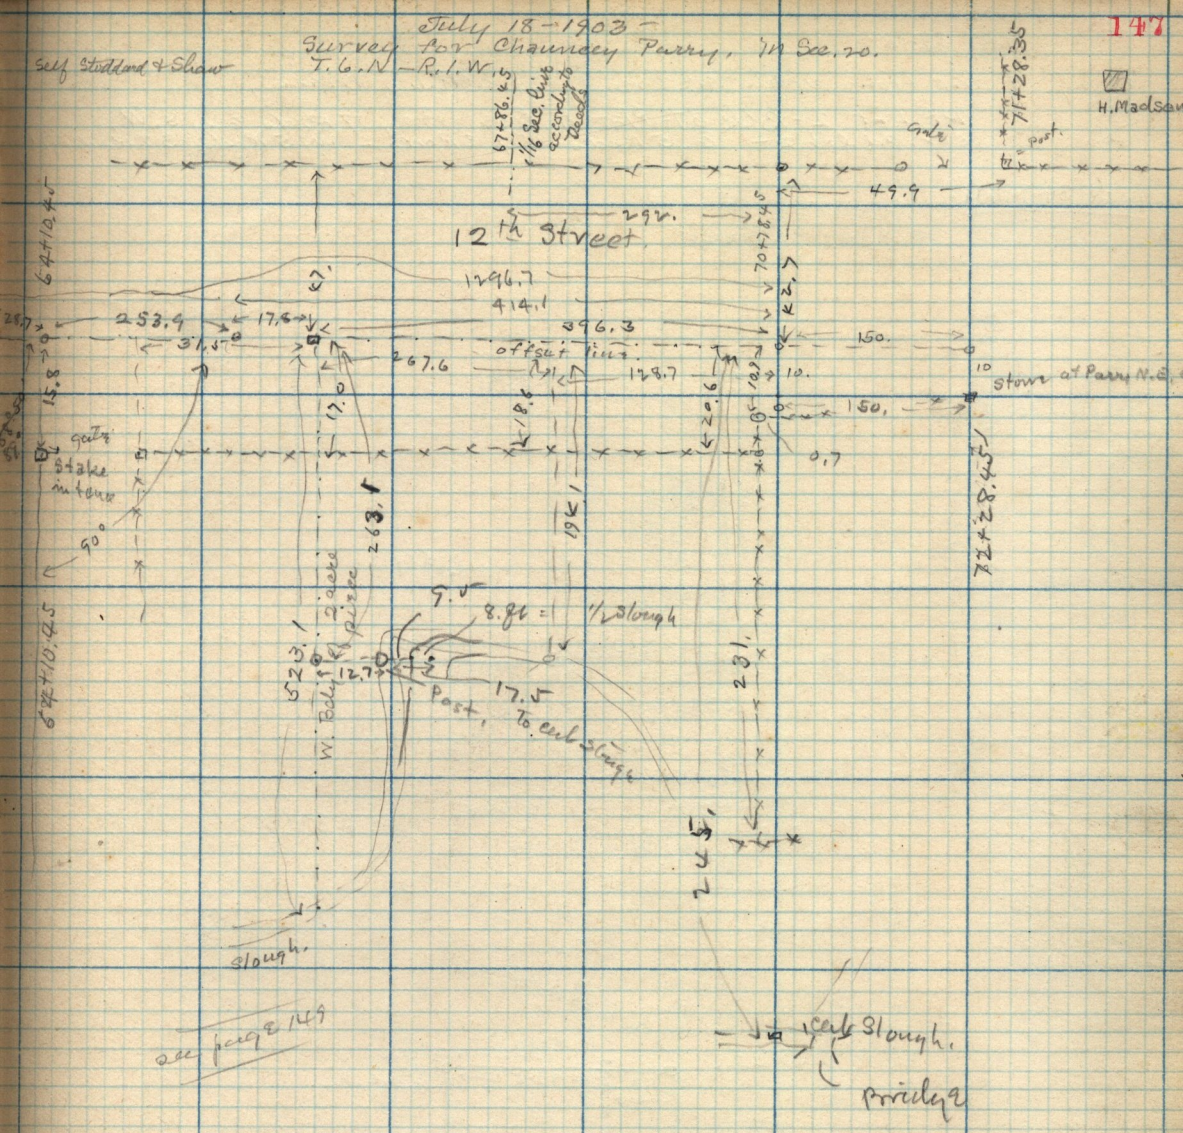

3-25 - Copy of deed from Warren G. Child to Jos. Parry - Beg. 331. ft. S. & 442.0 ft. E. from center of N.W 1/4 Sec. 20. T. 6 N - R. 1. W. Thence S 28° 45' W 283. ft - N 63° W 160. ft - S 69° W 276. ft, S 2° 30' W, 232. ft, S 60° 30' W 219. ft - S 8° E 206. ft - S 81° 30' W 110. ft - S 34° 20' W, 110. ft - N 64° 30' W 522. ft - S 45° W. 200. ft - N 810. ft - to S. line of Street. E. along S. line of said Street to beg. 18.6 a.

Aug. 4-03 - Copy of description issued to Chauncey Parry of part of the above land to be conveyed to - Hunter. Beg. 331.0 ft. S. and 292. ft. E from the center of the N.W 1/4 Sec. 20. T. 6. N - R. 1. W - S 224.4 ft. N. 69° W 137.0 ft S 73° 20' W. 248. to center of slough, W. 48.0 ft, N 246.1 ft. to S. line St, E 414.1 ft. along S. line St. to beg. 2. a.

Aug. 31-03 Copy of description of land deeded by Parry to Zeimer - all lands South of a line which begs 389.5 ft. E. and 199.9 ft. N. of the 1/4 Sec. cor. bet Secs 19 & 20, T. 6. N - R. 1. W. and running thence N 89° 20' E 763. ft. intersecting Broome Creek Bridge.