Sept. 17-08
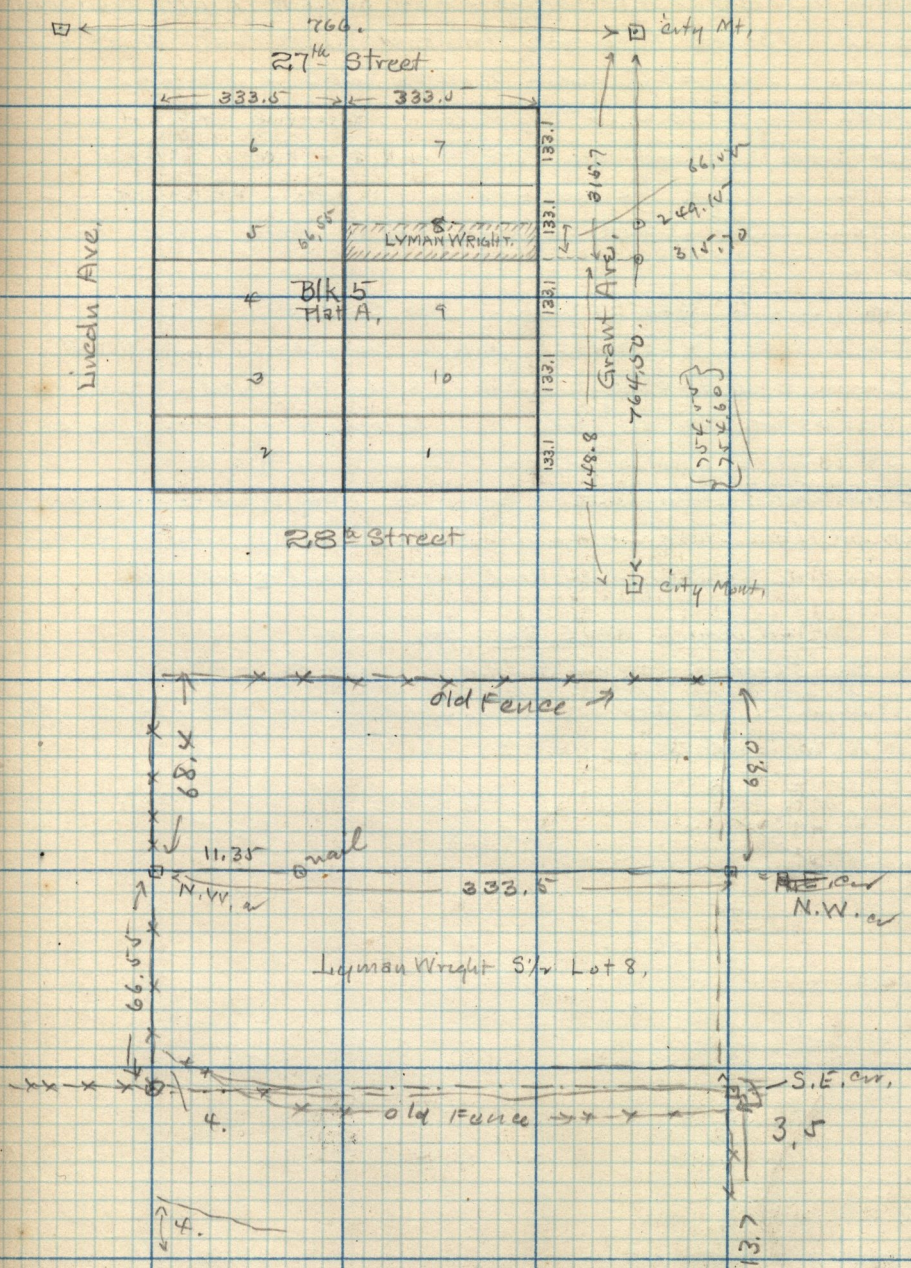
Copy of Abstract by Lyman Wright - S½ Lot 8 - Block 5 - Plat A. O.C.S -