

80.0  
13.5  
78.5

161

241.  
35.32  
205.68

39.77  
33  
40.10

8.8  
6.92  
1.88

Nov. 5 - 1901  
Sketch of measures of property lines  
fronting E. side Washington bet 26 & 27  
(Block 12 - Plat A)

From page (160)

19.  
91.88  
33  
92.21

220  
14  
206

89-81-30  
04-20  
89-85-50  
90-24-10  
9.8  
60


150  
149-13  
30-07  
241.  
220  
21.

22.85  
33  
23.27

49.0  
91  
140.5  
20.45  
116.75  
13.7  
1130.25

140.5  
31.15  
171.65  
140.5  
241.0  
381.5  
49.5  
332.0

Washington Ave.

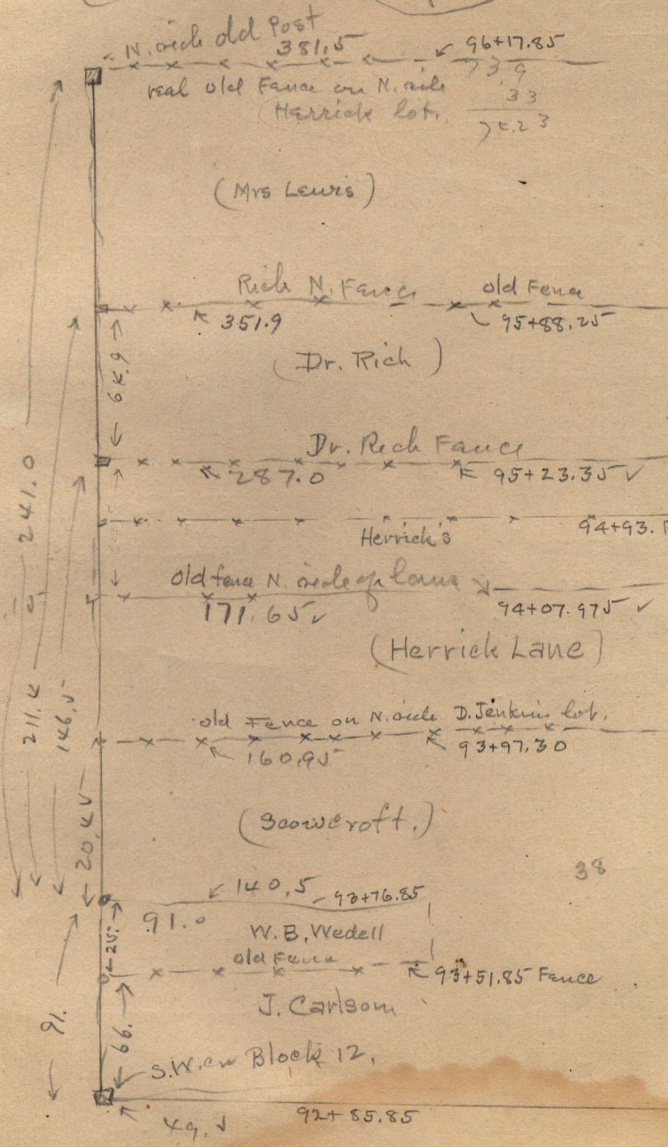

27th Street