162
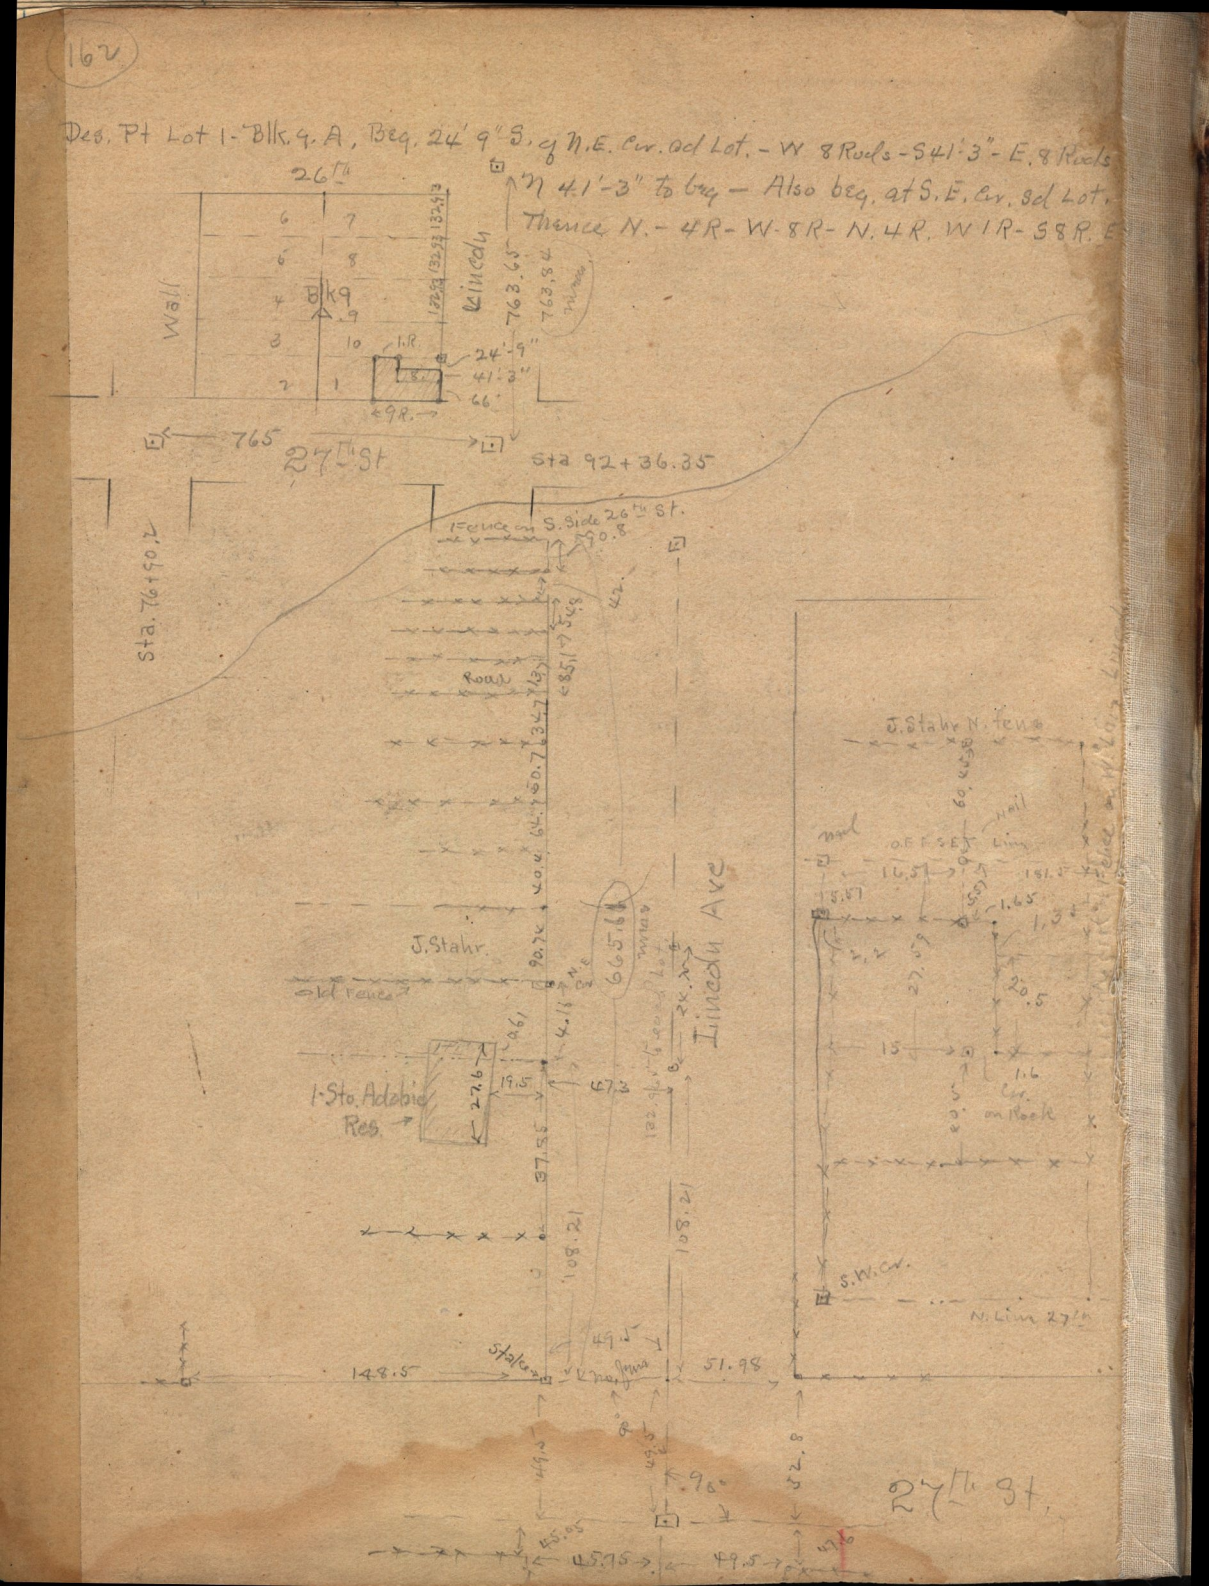
Des. Pt Lot 1- Blk. 9. A, Beg. 24' 9" S. of N.E. Cor. of Lot. - W 8 Rods - S 41' 3" - E. 8 Rods - N 41'-3" to beg. - Also beg. at S.E. Cor. 3d Lot. Thence N. - 4R - W - 8R - N. 4R. W 1R - S 8R. E