


May 26-1952

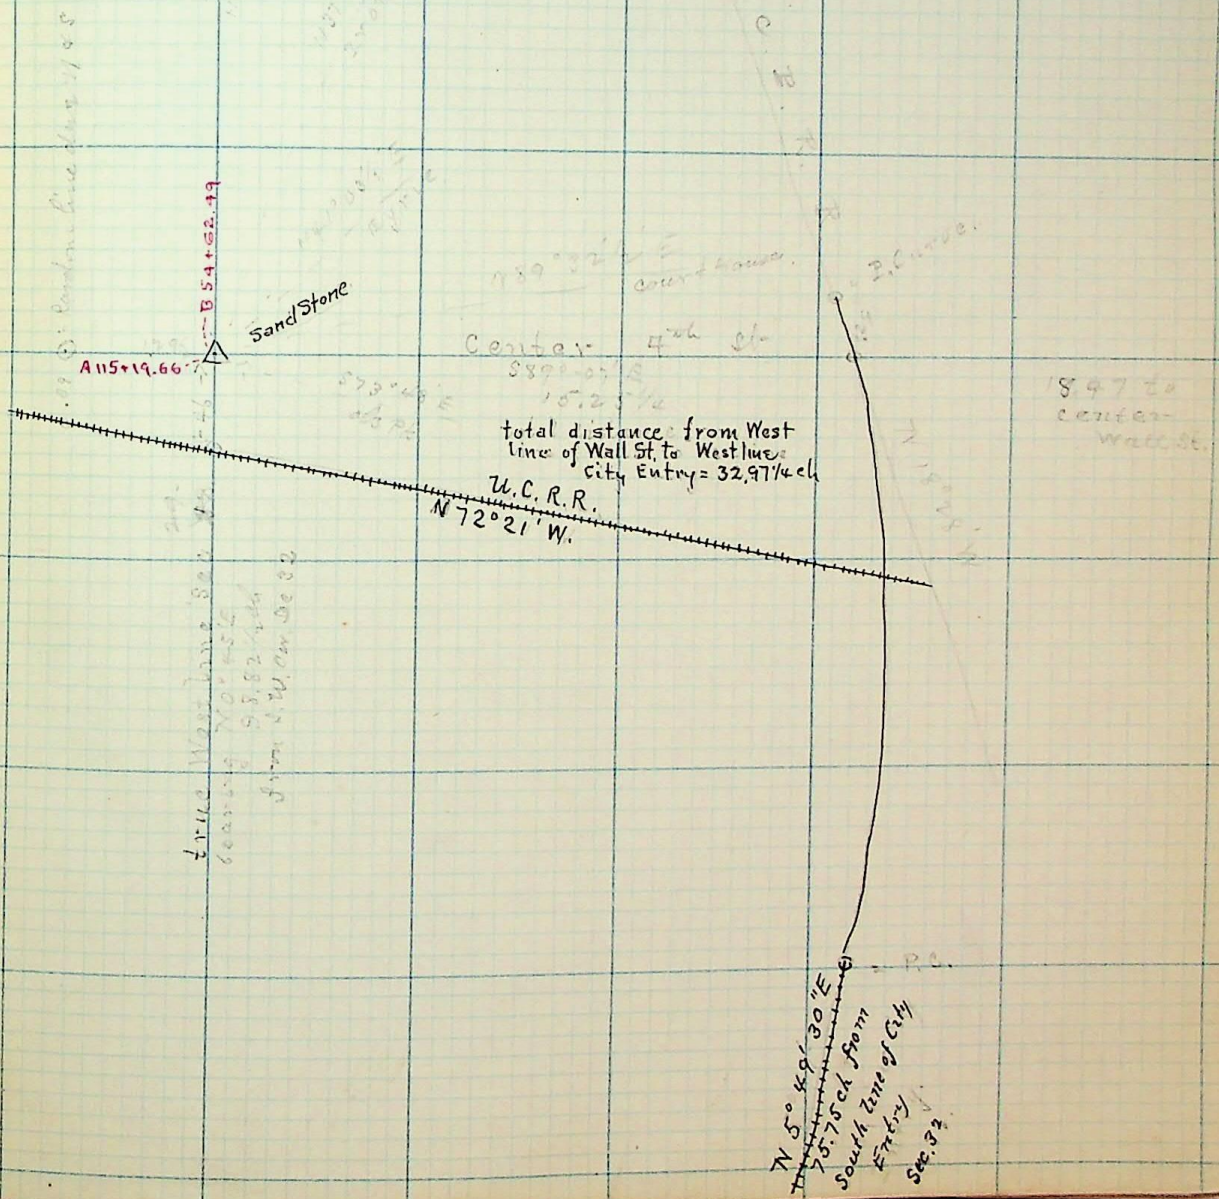

D: Random Line 115 + 19.66

 58.82 ch
 from S.W. cor. Se 32

Center
889° 07' E
15.25 ch

N 5° 49' 30" E
 75.75 ch from
 South Line of City
 Entry
 See p. 32