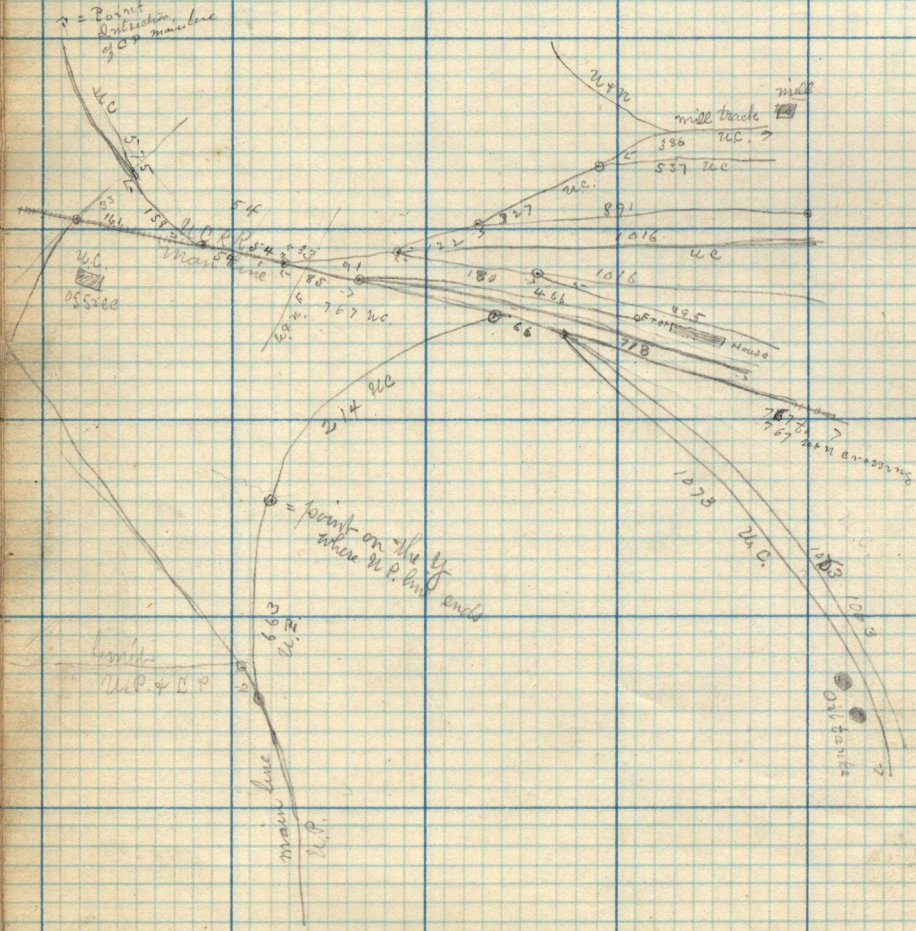
P = Point of intersection of two main lines
W.C.
W.C.
D.S. & C.
Main line
W.C.
W.C.
W.C.