42

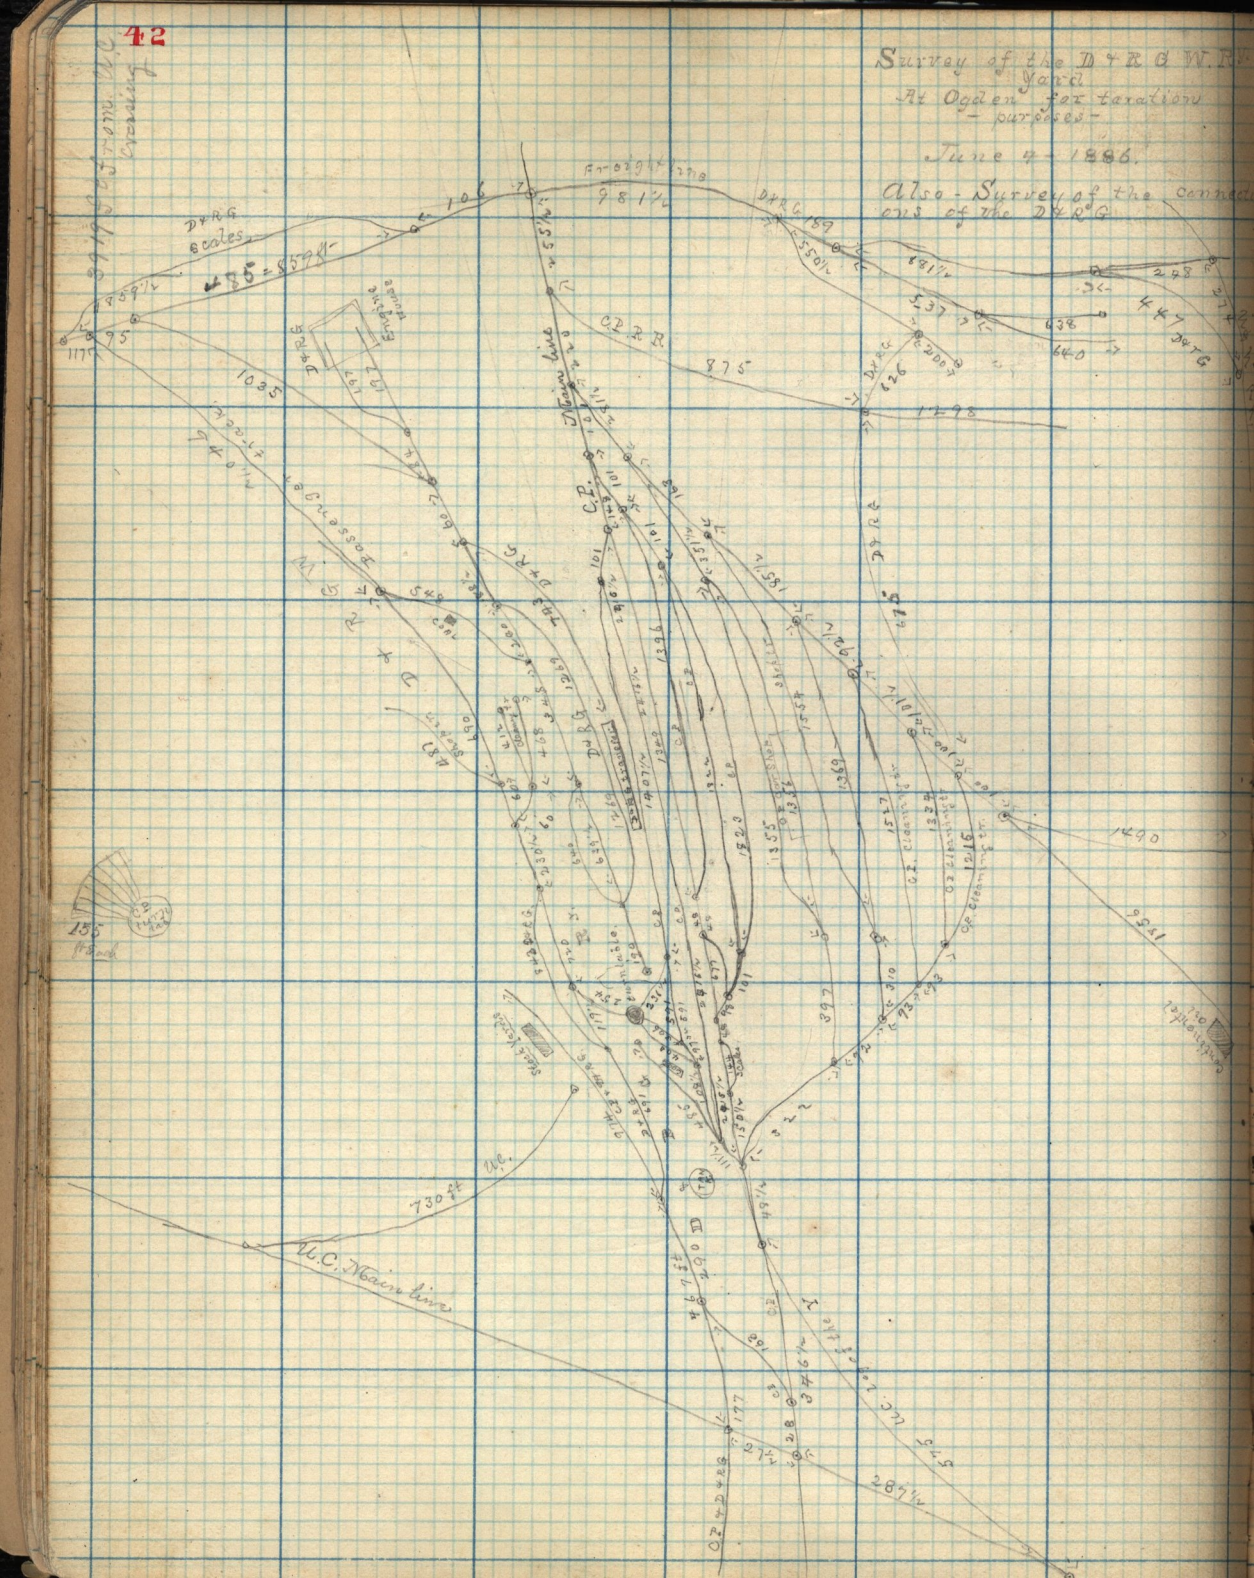
Survey of the D & R G W. R.
Yard
At Ogden for taxation
purposes
June 4 - 1886.
Also - Survey of the connections of the D & R G
D & R G
Scales
Straight line
C. P. R. R.
U. C. Main line
U.C.
