


Part of
 Block 7 - Ogden 5 Uere Plat
 Feb. 28-1887.

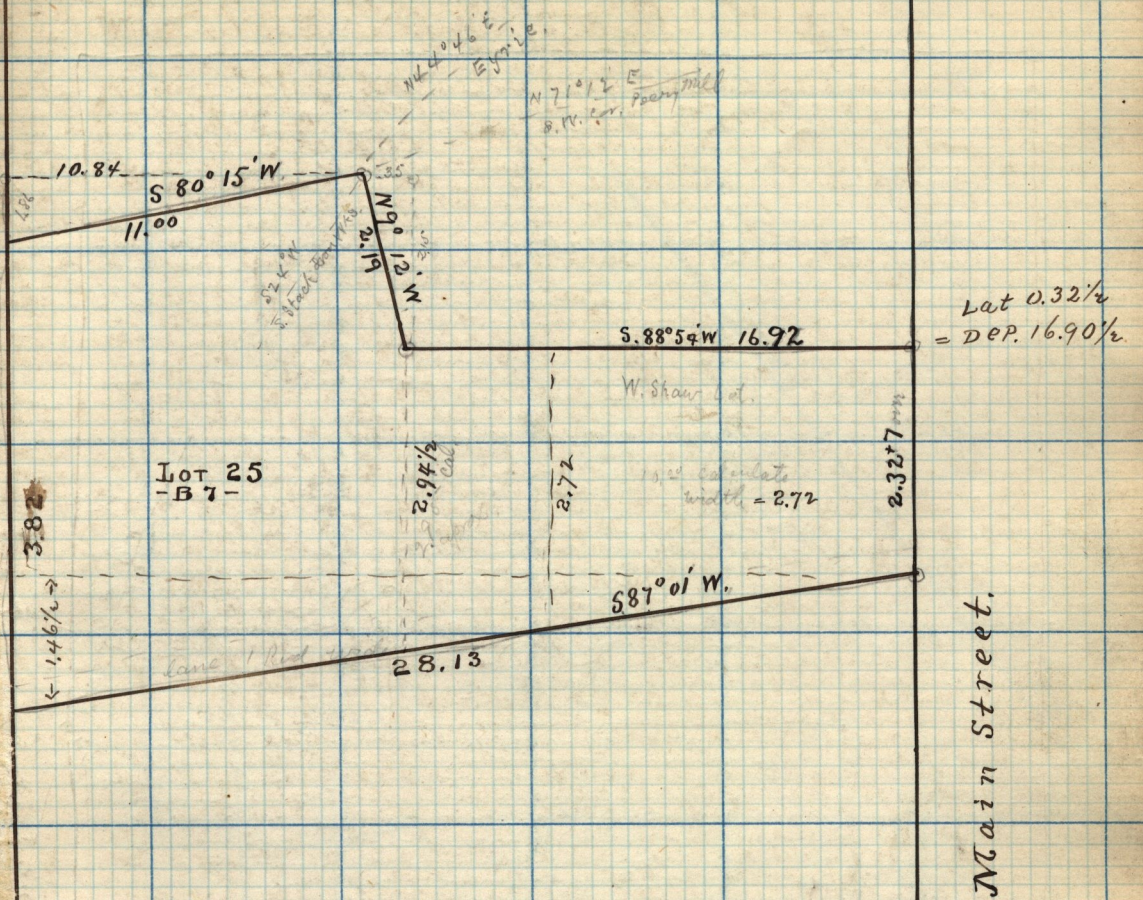

Lat $0.32\frac{1}{2}$
 = DEP. $16.90\frac{1}{2}$

Main Street.

to point where piece
 Widens out = 4.52 a.
 Widest = 5.34 a.
 total in lot 25 = 9.86 a.