46
48
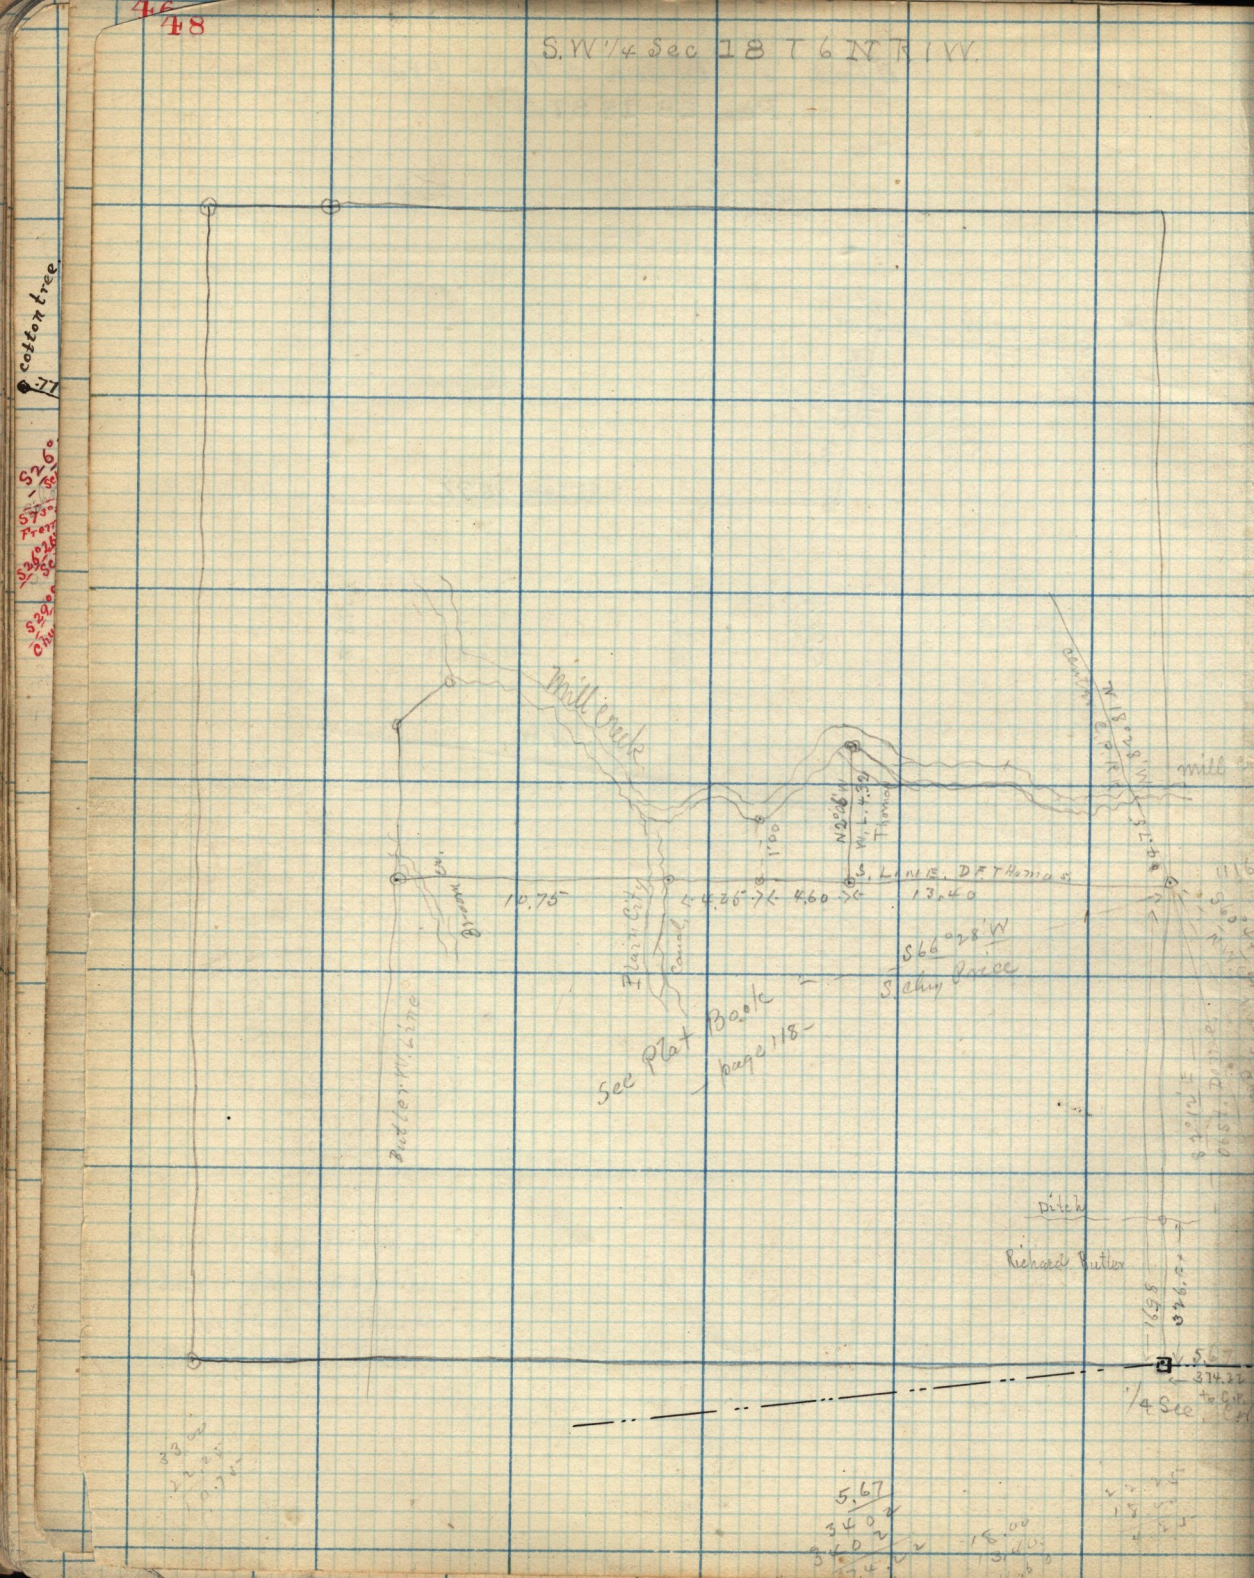
S.W.¼ Sec 18 T 6 N R IV W.