


Cub Run + Vornu Creek Reservoir
Pavilion - Pa. Aug. 25 - 1907

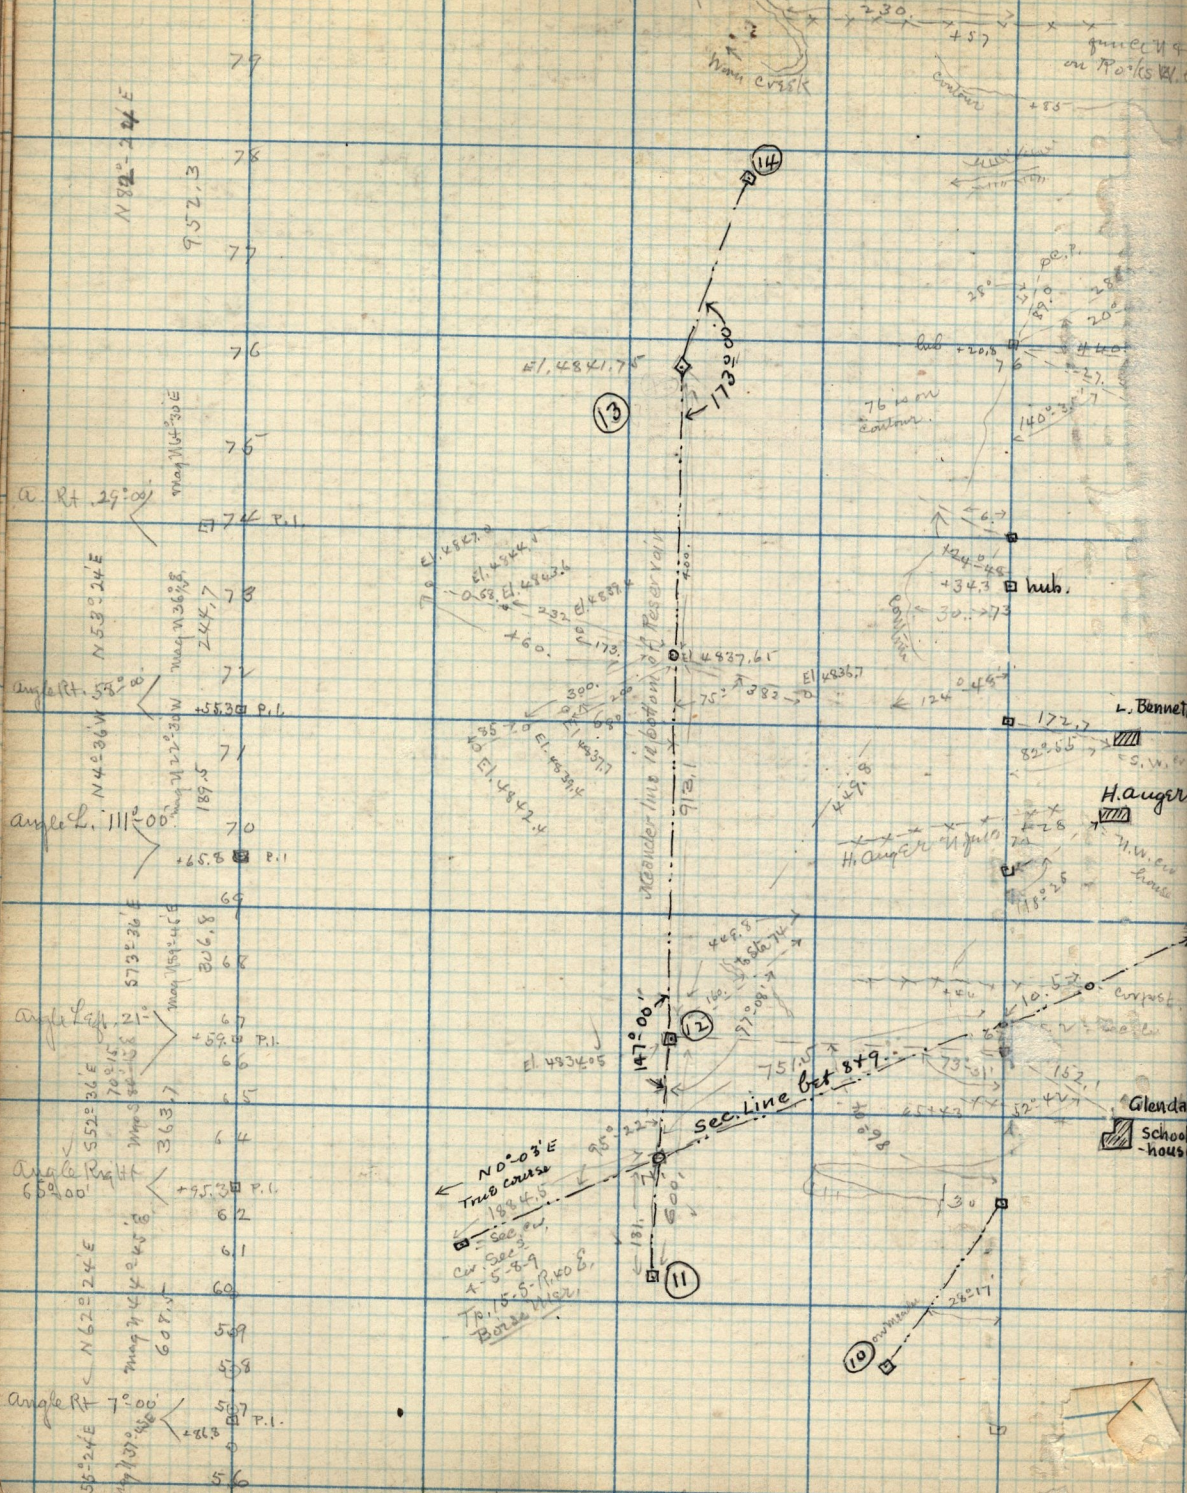

These notes are from Book DU page 23