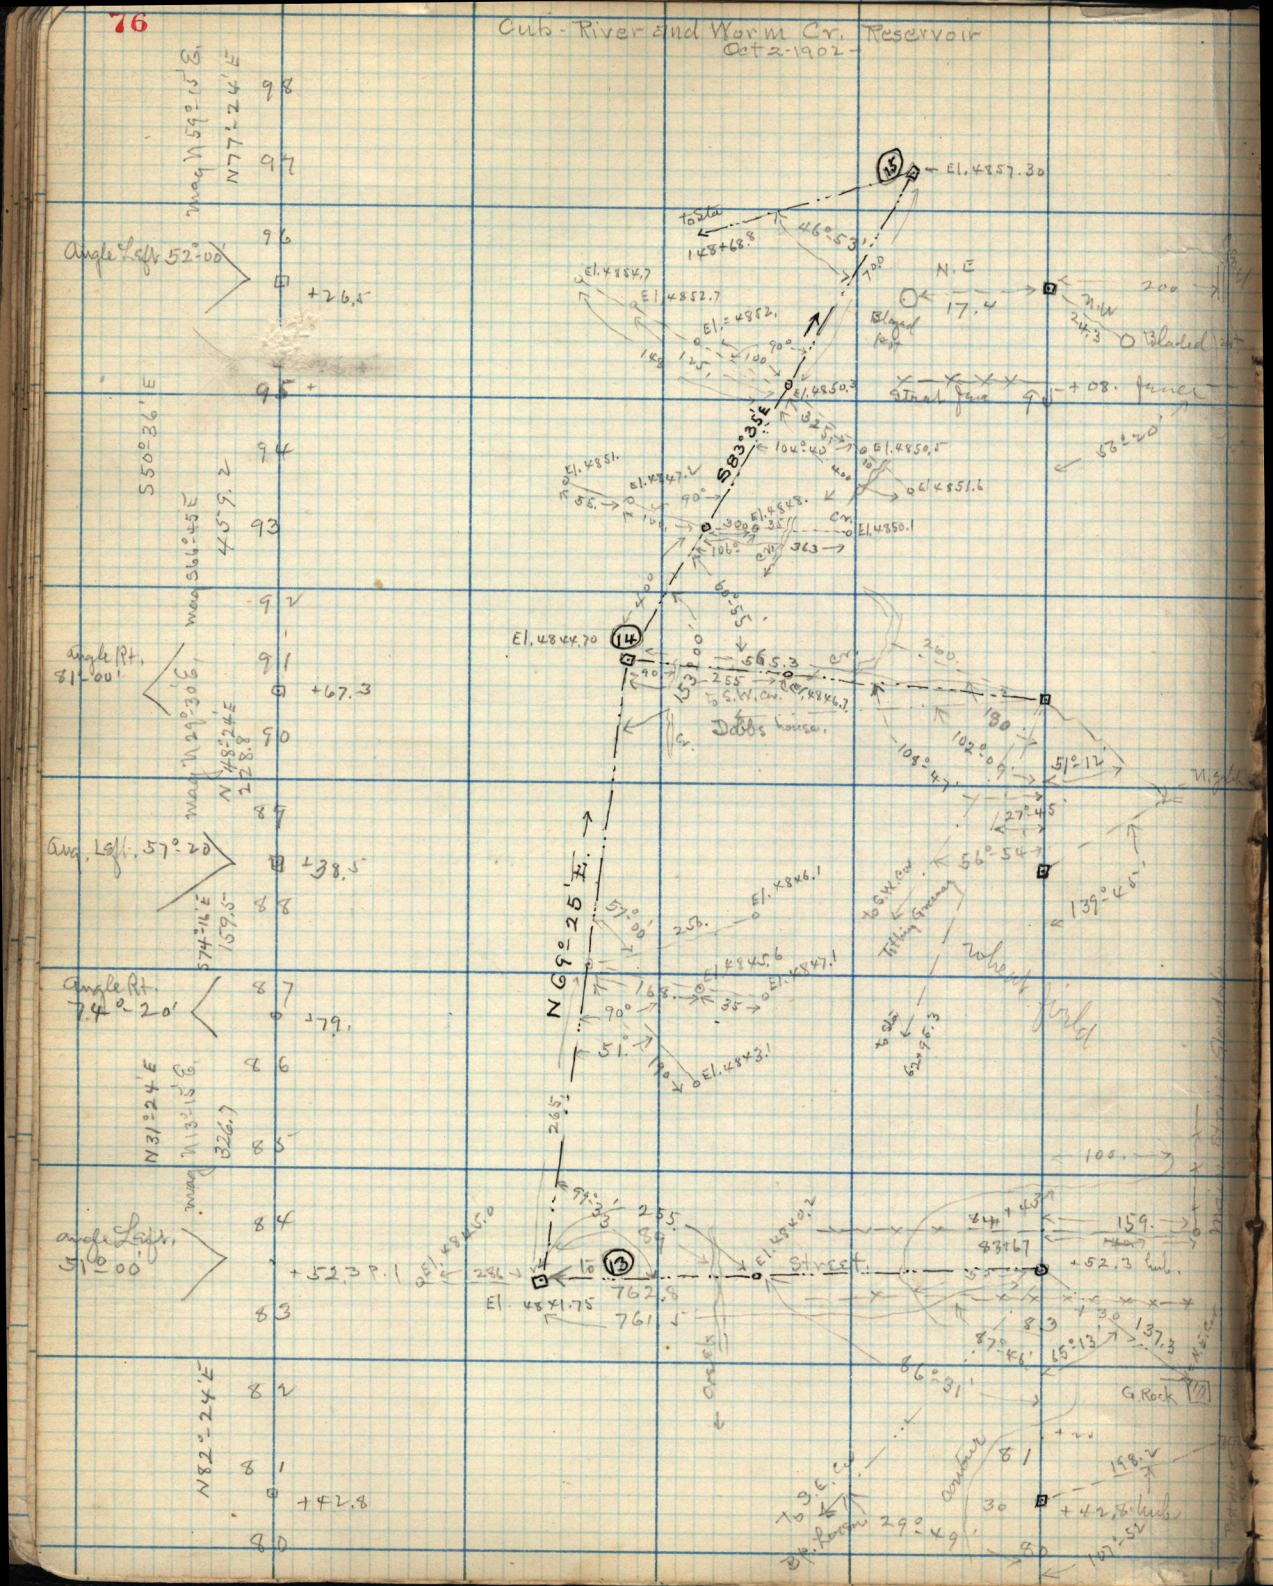Cub - River and Worm Cr. Reservoir
Oct 2-1902