

Cub-River and Worm Cr. Reservoir  
 Aug 29 - 1902

Reservoir

Angle Pt.  $31^{\circ}00'$   
 $53.2$   
 $+28.7$

Angle Pt.  $100^{\circ}00'$   
 $57^{\circ}17'E$   
 $26.9$   
 $+0.18$

Angle Left  $39^{\circ}00'$   
 $868^{\circ}17'E$   
 $165.9$   
 $+74.6$   
 $+08.1$

Angle Left  $24^{\circ}00'$   
 $54^{\circ}27'E$   
 $153.2$   
 $+56.5$

Angle Left  $17^{\circ}00'$   
 $58^{\circ}17'E$   
 $97.8$   
 $+57.7$

Angle Left  $22^{\circ}00'$   
 $51^{\circ}43'W$   
 $136.2$   
 $+21.5$

Angle Left  $36^{\circ}00'$   
 $35^{\circ}35'$   
 $53^{\circ}24'43'W$   
 $273.1$   
 $+48.4$

Angle Left  $35^{\circ}35'$   
 $56^{\circ}15'W$   
 $172.4$   
 $227.2$

294

293

292

291

290

289

288


287

286

285

284

283

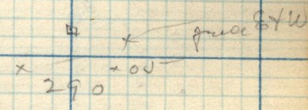

□ = See page