Sept 8-1902

Made Survey in Sec. 9, Tp. 6 N- R. 2. E. Salt Lake Meridian for N. H. Nielson & Ves. Grow of Huntsville -

22.9 a. of Land in S.W. ¼ Sec 9 Tp. 6 N - R. 2 E. to be conveyed by Sylvester Grow to N. H. Nielson -

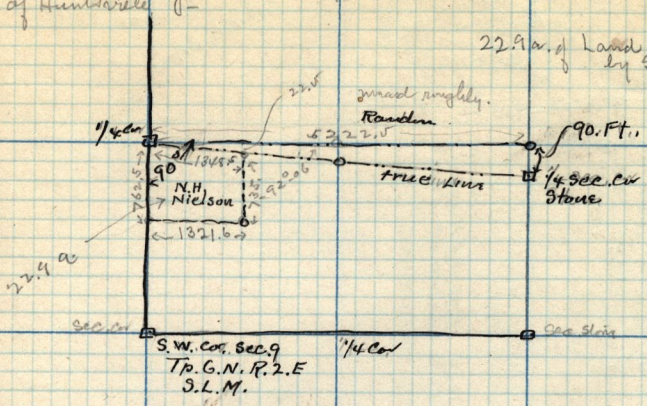
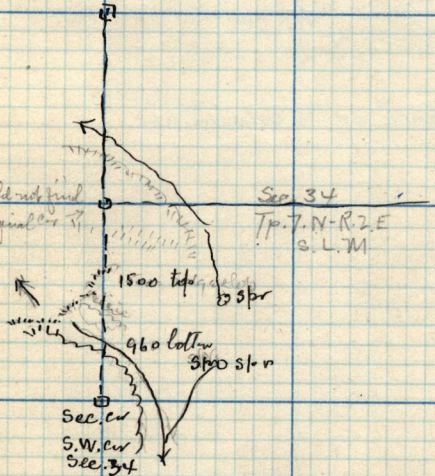
Survey in Sec. 34 Tp. 7. N-R. 2 E. for Sylvester Grow Sept 9-1902 -