


June 23-1884

Block 3 is 5 ft Excess East & was 9 blocks 2 is 7 links too large. Later survey from the Rock at 8th & Main shows Block 3 - to be 4.3 ft Excess.

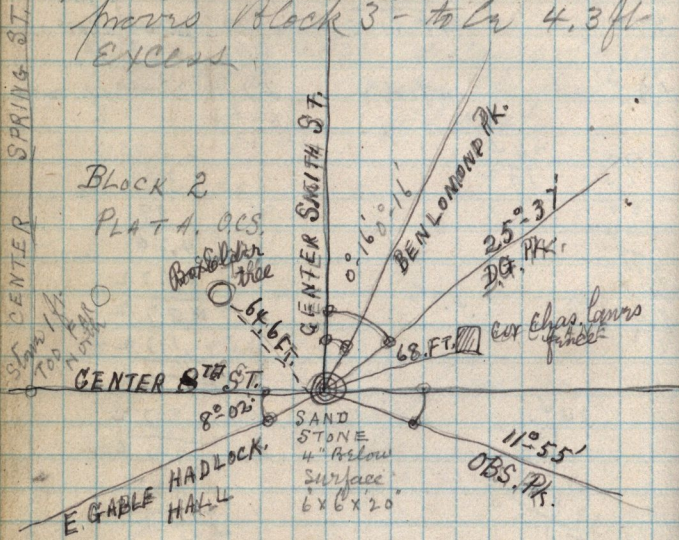

Block 2

PLATA. OCS.

Block 2
the

CENTER 8TH ST.

CENTER SMITH ST.

BEN LOMOND PK.
0° 16' 0"

25° 37'
D.G. PK.

cur Chap. Lovers
fence

68 FT.

8° 02'

SAND
STONE
4" Below
Surface
6x6x20

E. GABLE HADLOCK.

11° 55'
OBS. PK.

Block 2 is 4.62 ft Excess E + W, or 7 links = 92 ft to End of

64.6
49.1
15.6

3.00

3.65
5.00
1.35

78
63
15

4.62
92