


JULY 16 1884.

55

M.

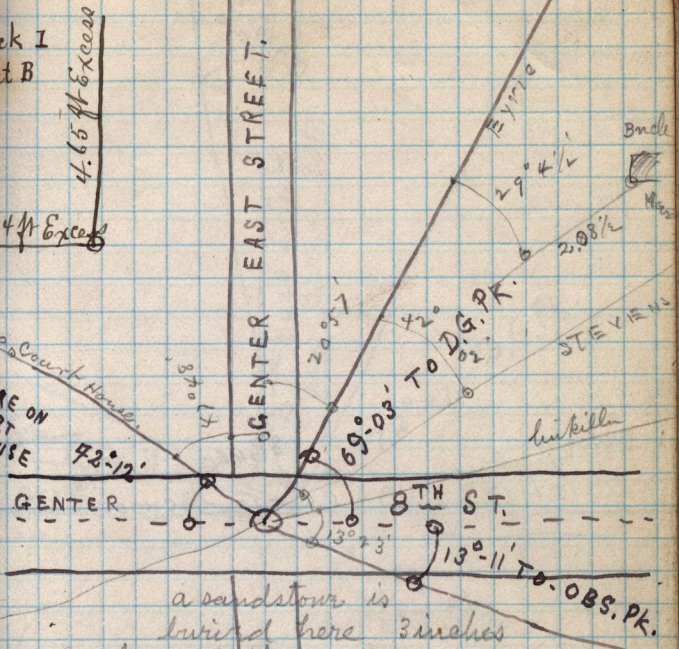

a sandstone is buried here 3 inches

below the surface

4" x 4" x 2 ft with hole

drilled in top. cost 40 cts

Sam. Hammond assisted in placing it and it is at right angles to Main St.

Note This point was afterwards found to be 1.2/100 ft too far East.

5°-11'
Court House