


July 16 - 1884  
57

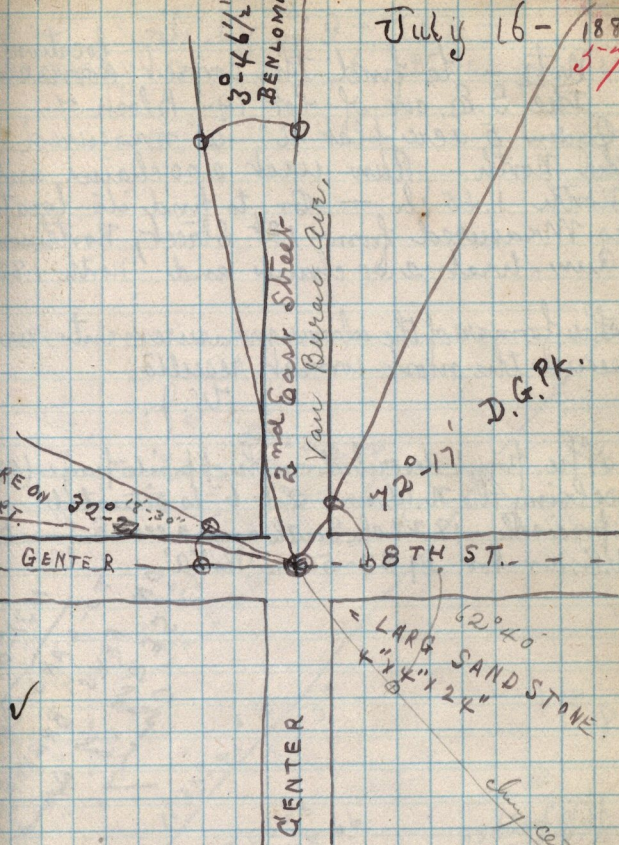

Rob Van Dyke assisted in  
placing the above stones  
Ordered by Ogdun City