


Block 67  
41

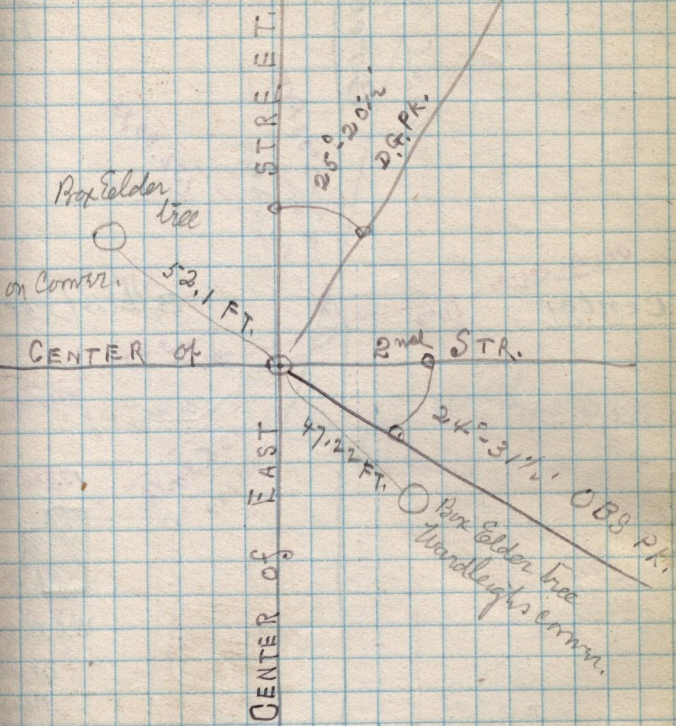

Aug 12-1884