


06
3-41
90-80

20.5
27.5
28.0

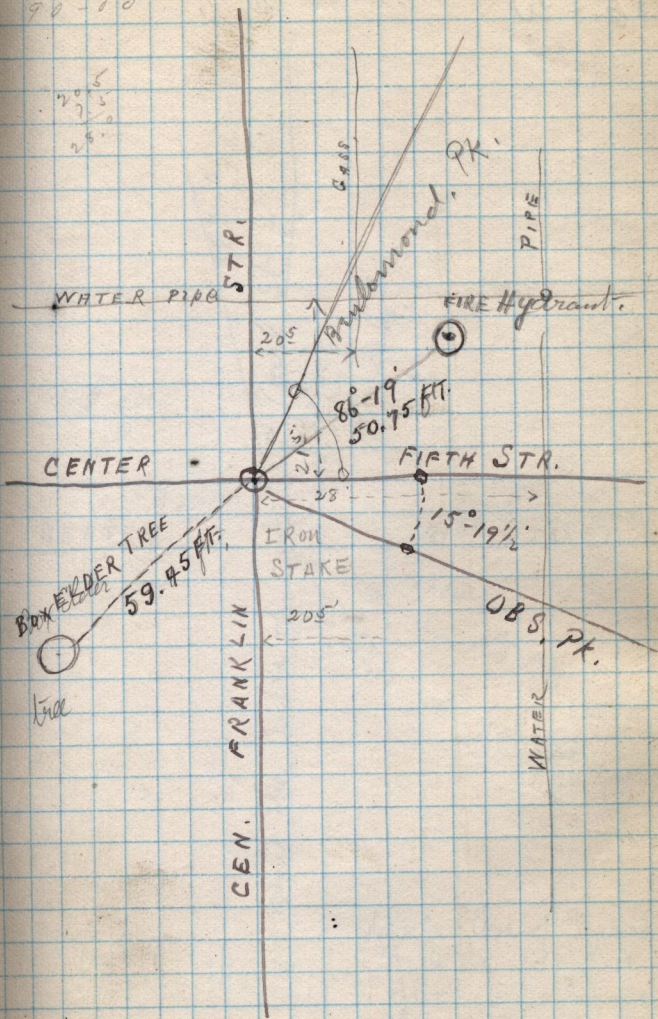

Aug 25-1884