


ny ny

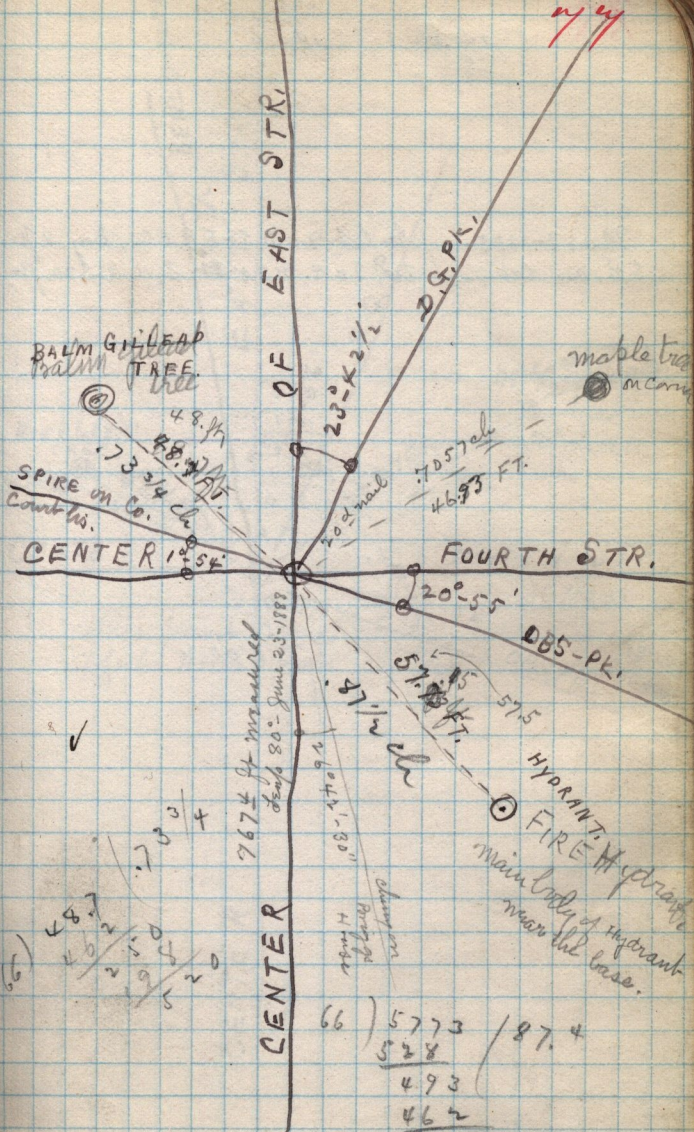

✓
 48.7
 46.2
 29.5
 52.0
 20

767 1/2 ft measured
 temp 80° - June 23-1883

66) 5773 / 87.4
 528
 493
 462

