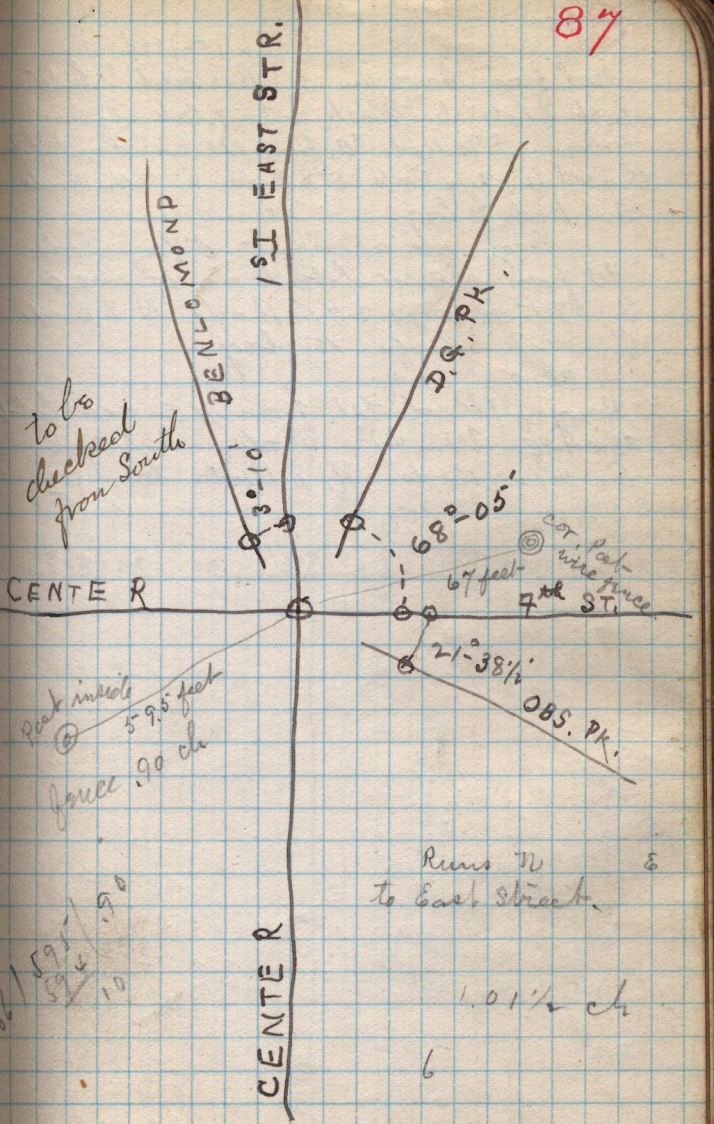
1st EAST STR.
BENLOMOND
D.G. PK.
to be checked from South
3°-10'
68°-05'
cor. post wire fence
67 feet
CENTER
7th ST.
21°-38½'
OBS. PK.
post inside
59.5 feet
fence .90 ch
Runs N E
to East street.
1.01½ ch
6
CENTER

