


CENTER GREEN ST.

EN.

3rd St.

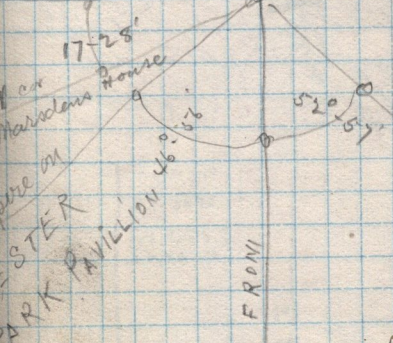

STER
PARK PAVILLION

571 FT EAST FROM

to be checked

NORTH gable
Rm Chamber
Rock House