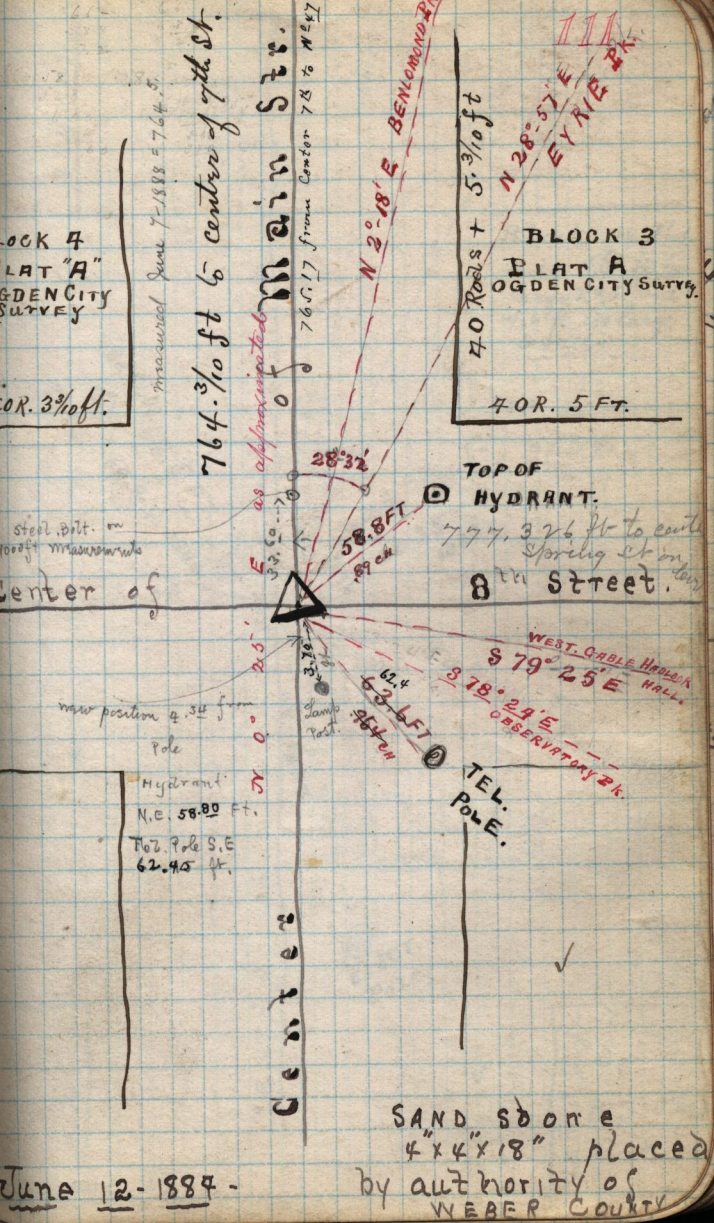

SAND STONE
4"x4"x18" placed
by authority of
WEBER COUNTY

June 12-1884-