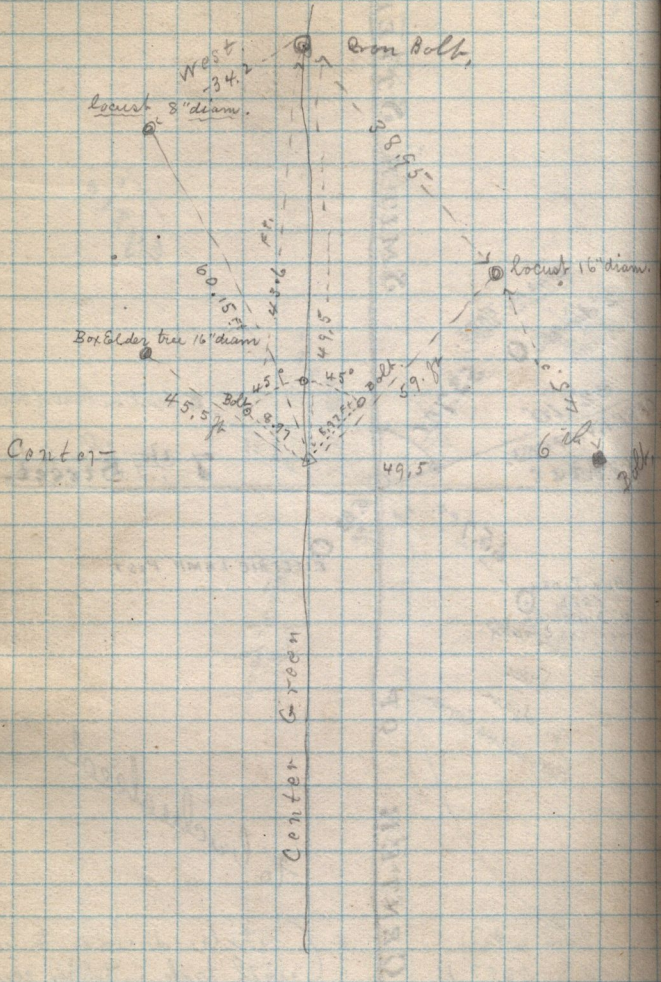
Iron Bolt
West
34.2
Locust 8" diam.
Locust 16" diam.
Box Elder tree 16" diam
Bolt
Center
Center