


3rd East  
ST

170

EX-10

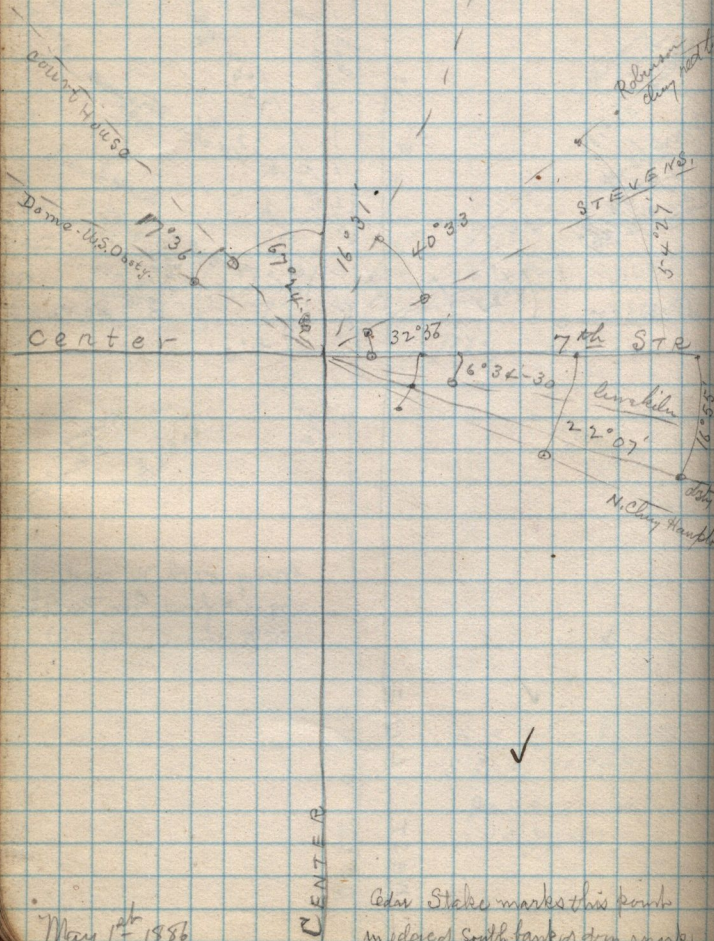

May 1<sup>st</sup> 1886

CENTER

Cedar Stake marks this point  
in edge of South bank of dry creek