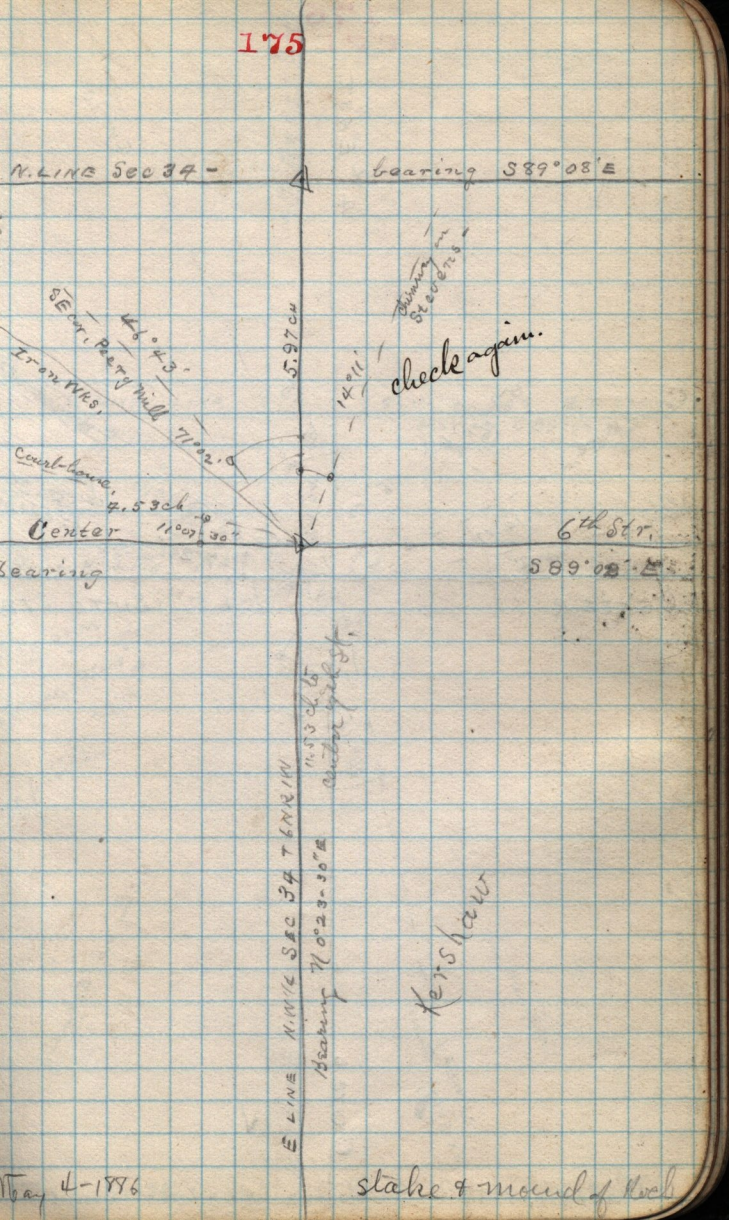
N. LINE Sec 34 -
bearing S89°08'E
SE cor. Peery Mill
46°43'
Iron Wks.
71°02'
5.97 ch
14°11'
Chimney on Stevens
check again.
Court-house.
4.53 ch
Center
11°07'30"
6th Str.
Bearing
S89°08'E
11.53 ch to center 9th St.
E LINE N.W.¼ SEC 34 T6NR1W
Bearing N 0°23'30"E
Kershaw
May 4-1886
stake & mound of Rock