


WALL STREET.

2309.45 ft to center
Main.

CENTER

SIXTH STREET.

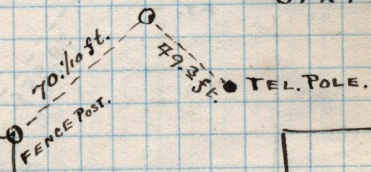

CENTER