



Pearl Str.


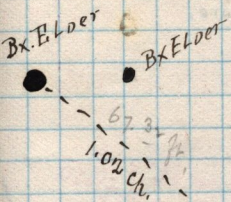


Center

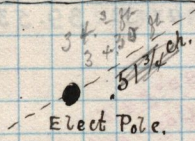

Bolt.

First Street

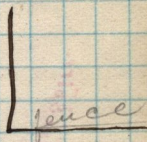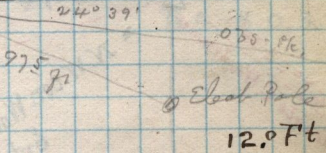

12.0 Excess
 between Block and
 and Creek 7 Strs.
 Plat B

Center

5475
 31050
 31050

1.5 feet Excess
 between Pearl + South
 on First

- OK -
 Done April 8-1887