


2104

Franklin D Richards  
Str.

Elyrie Pk.

7 ft S. from N. line  
8th Str., nail

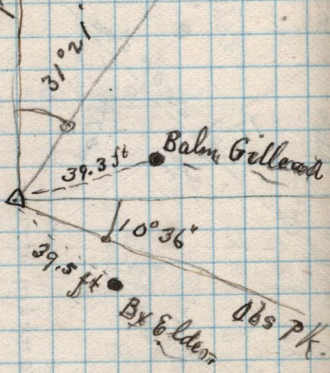

Being 22.40<sup>6</sup> ch.  
West from N. line of  
Main Street

center

$$\begin{array}{r} 49.5 \\ 7 \\ \hline 22.5 \end{array}$$

July 16-1897.