


19

20

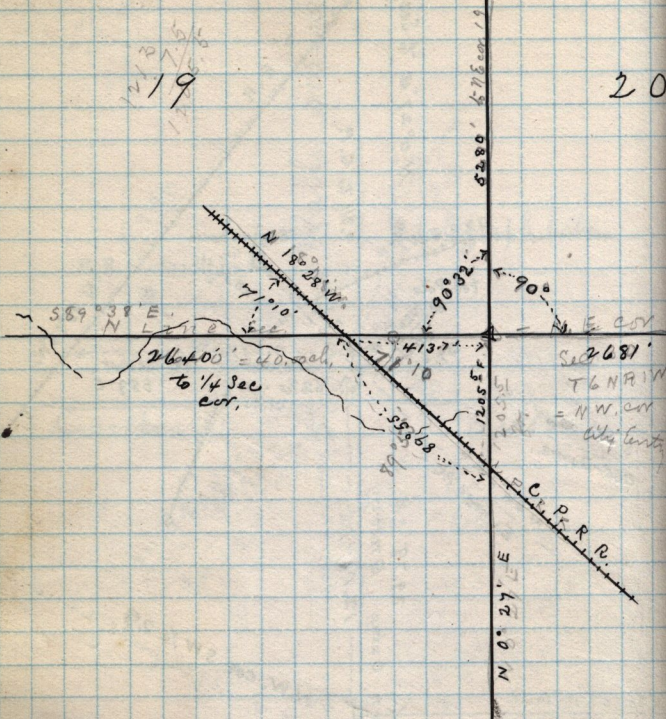

30

29

Jan 18-1899