


South double gates to Pavilion  
South double gates to Lester Park.

Picket fence.

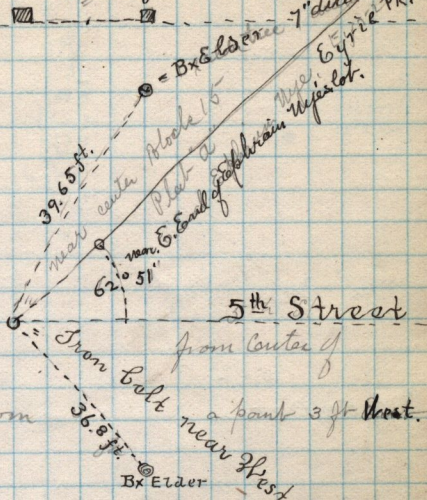

Center

357 ft East  
Smith  
and 399 ft W. from  
center Pearl St.

5th Street

From Bolt near a park 3 ft West.

Bx Elder

West line street  
arch set street  
near center of Block  
15 Plat "A"

399  
 357  
 756  
 94  
 ---  
 657