


St. Green St.

Center

7th Street

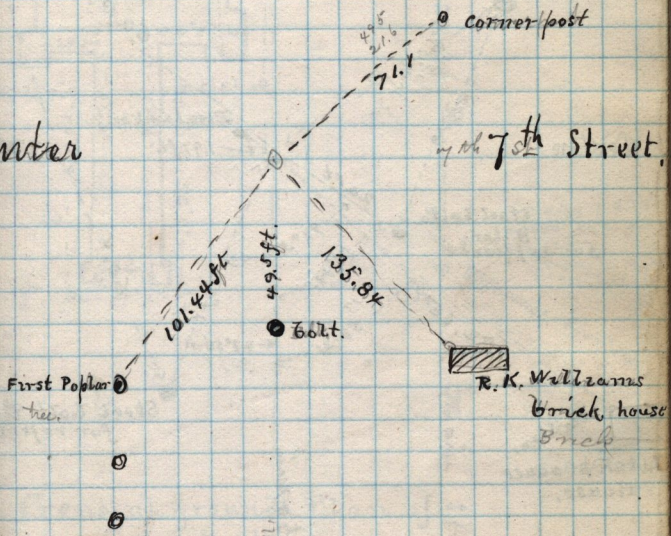

Center 7th St.

nail marks center
Corner & 7th