


49.5
32.65
82.15

Center Main

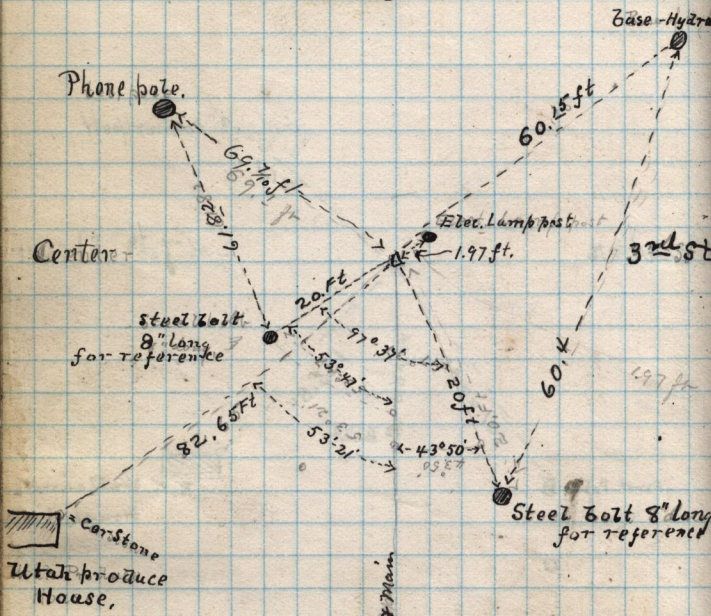

97-38
53-57
43-50
17-57

No nail marks
the center 3rd and
Main,

762.33 ft to Center 4 1/2 & Main