


Spring St

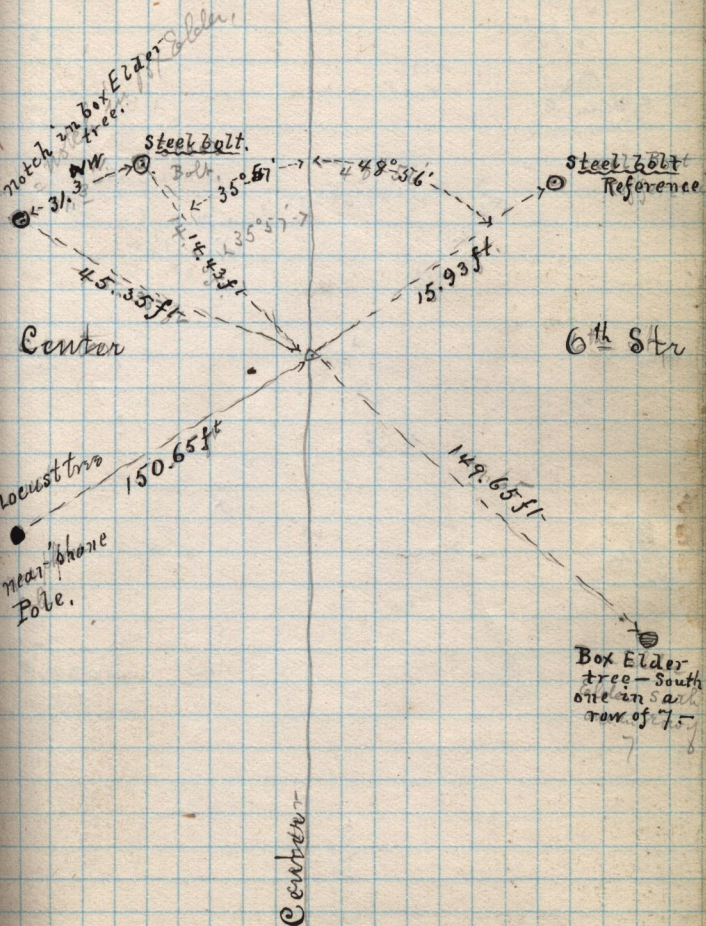

April 7-1888

nothing to mark the center of 6th & Spring