


Main

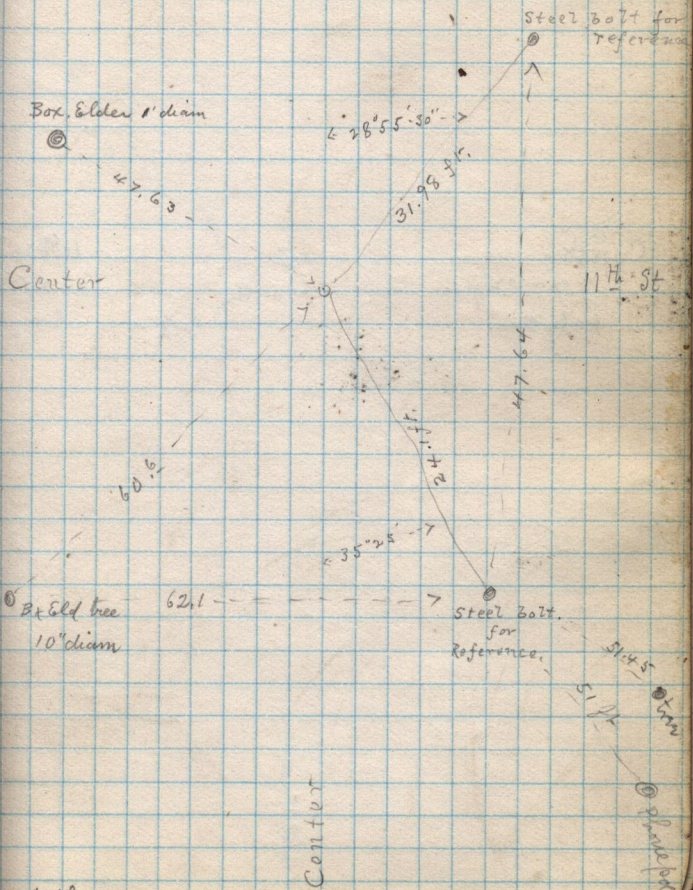

April 10-1888

Center

J. M. [unclear]