


231

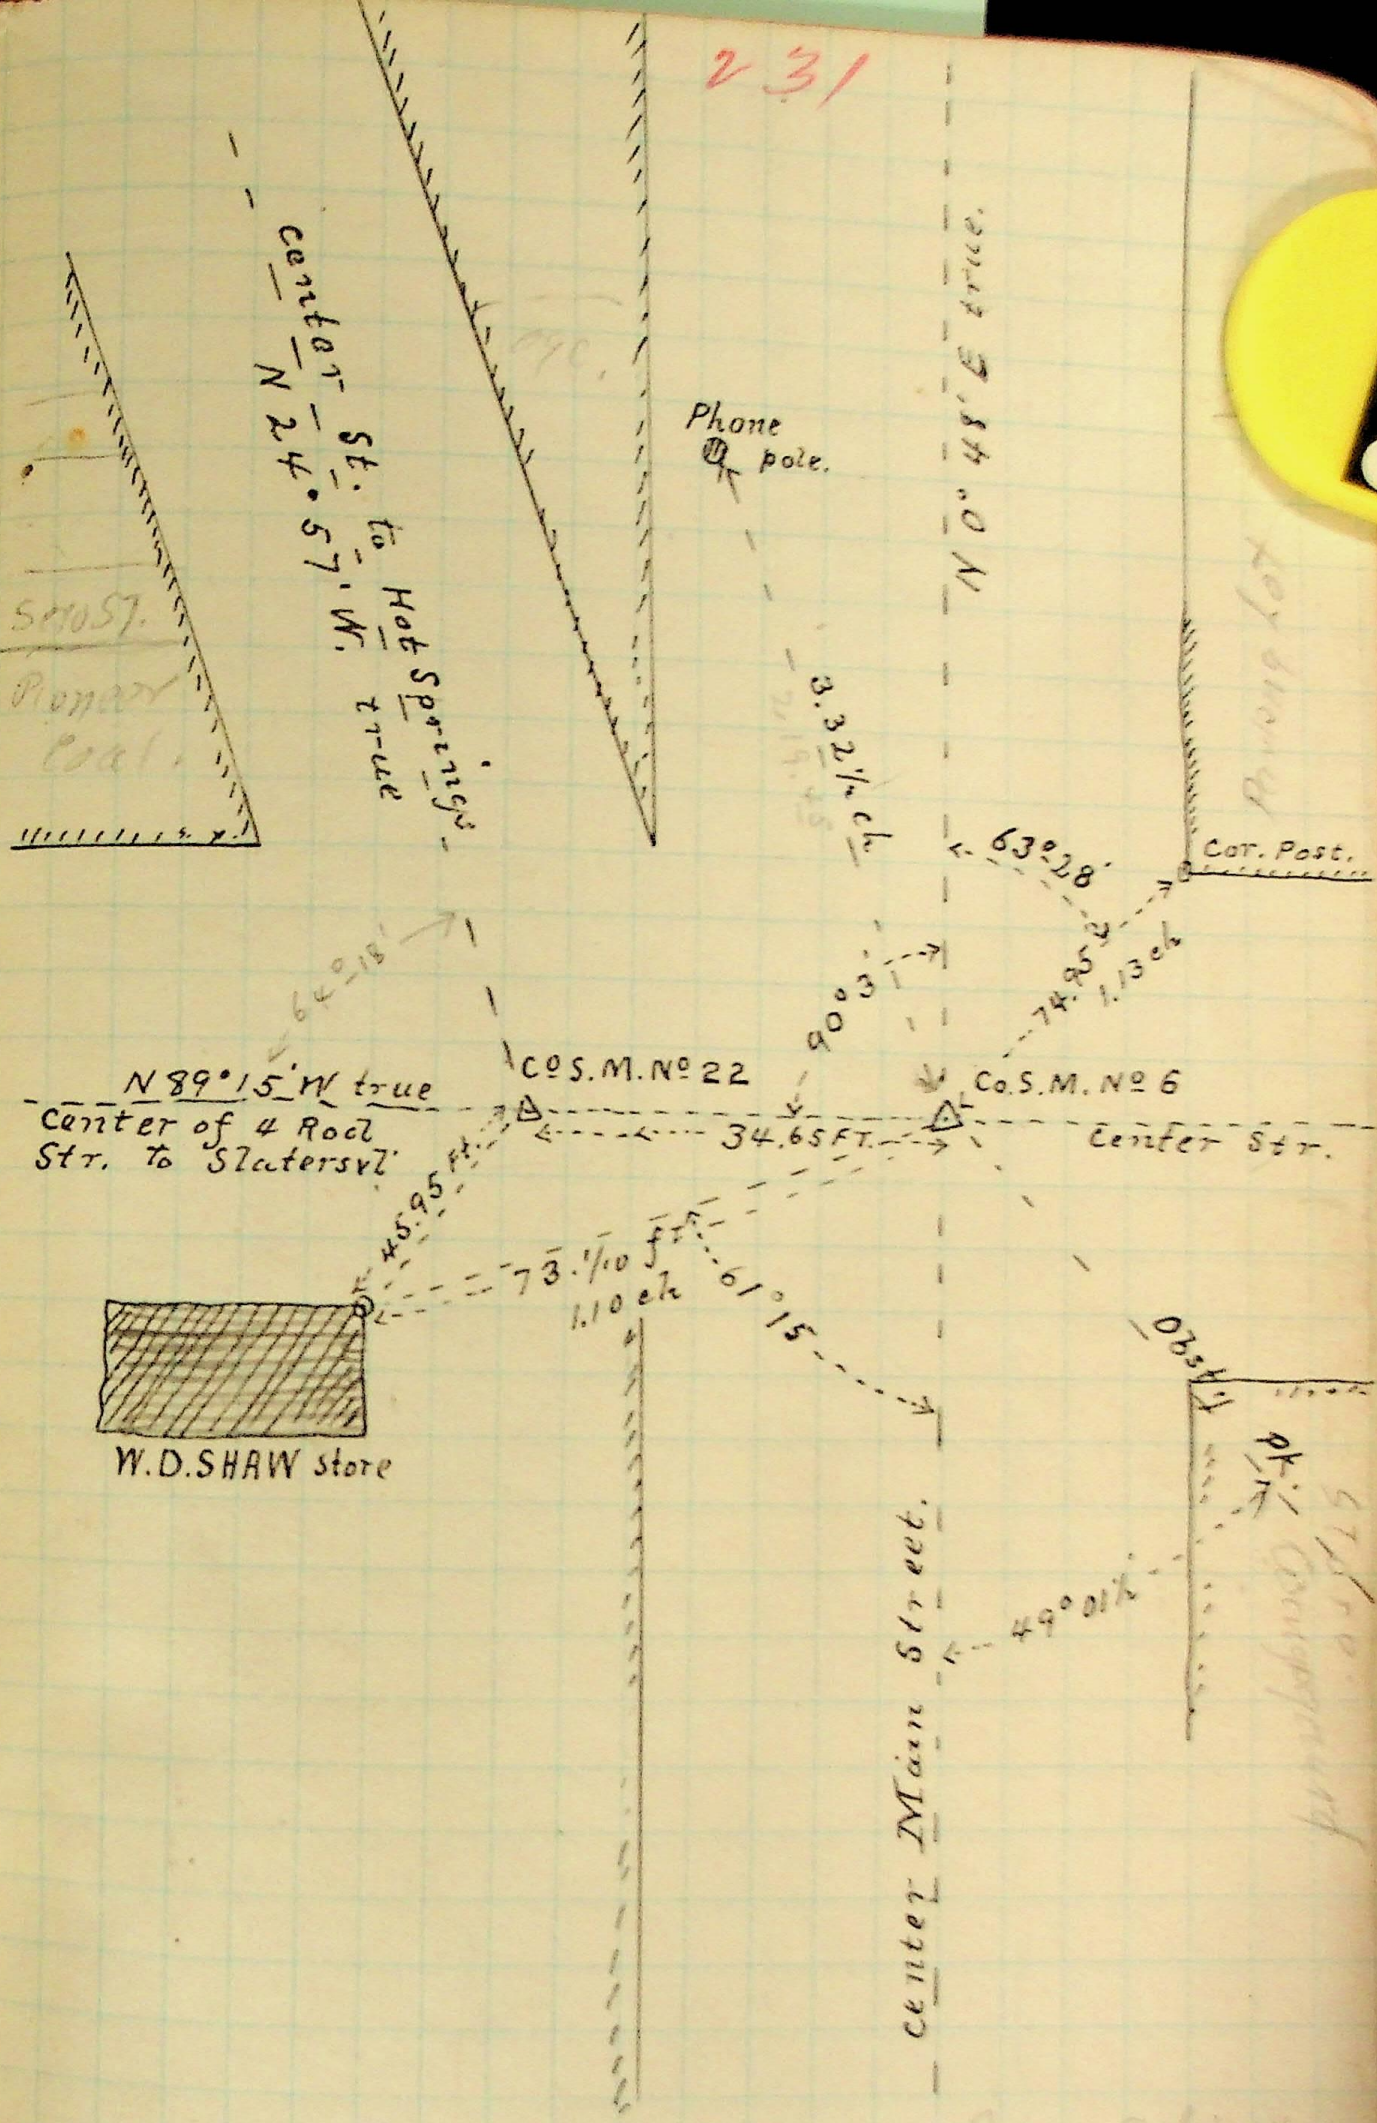

N° 6 is situated 21.69 ch S. and
11.16 1/2 ch W. from N.E. cor Sec
17 T 6 N R 1 W.

Begin on E. line to
21.69 ch S. from N. corner
17 S. 3.00 ch W. 5.02 ch
N. 3.00 ch S. 5.00 ch
and to S. to top.