


Quincy Ave.

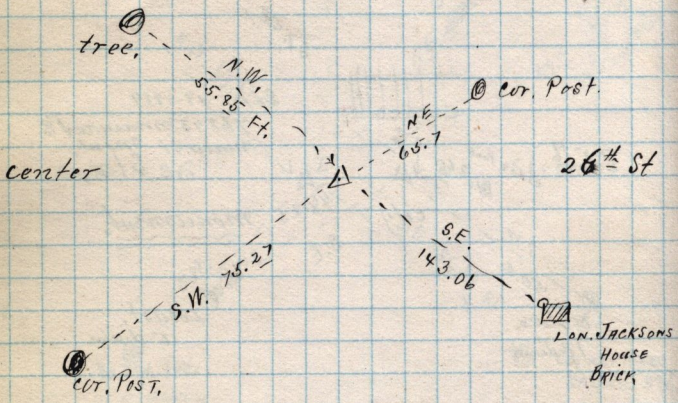

CENTER