


WASHINGTON AVE

243

alt. vol. 21 per above
top of cover 4306.41
water level 4297.9
4296.9

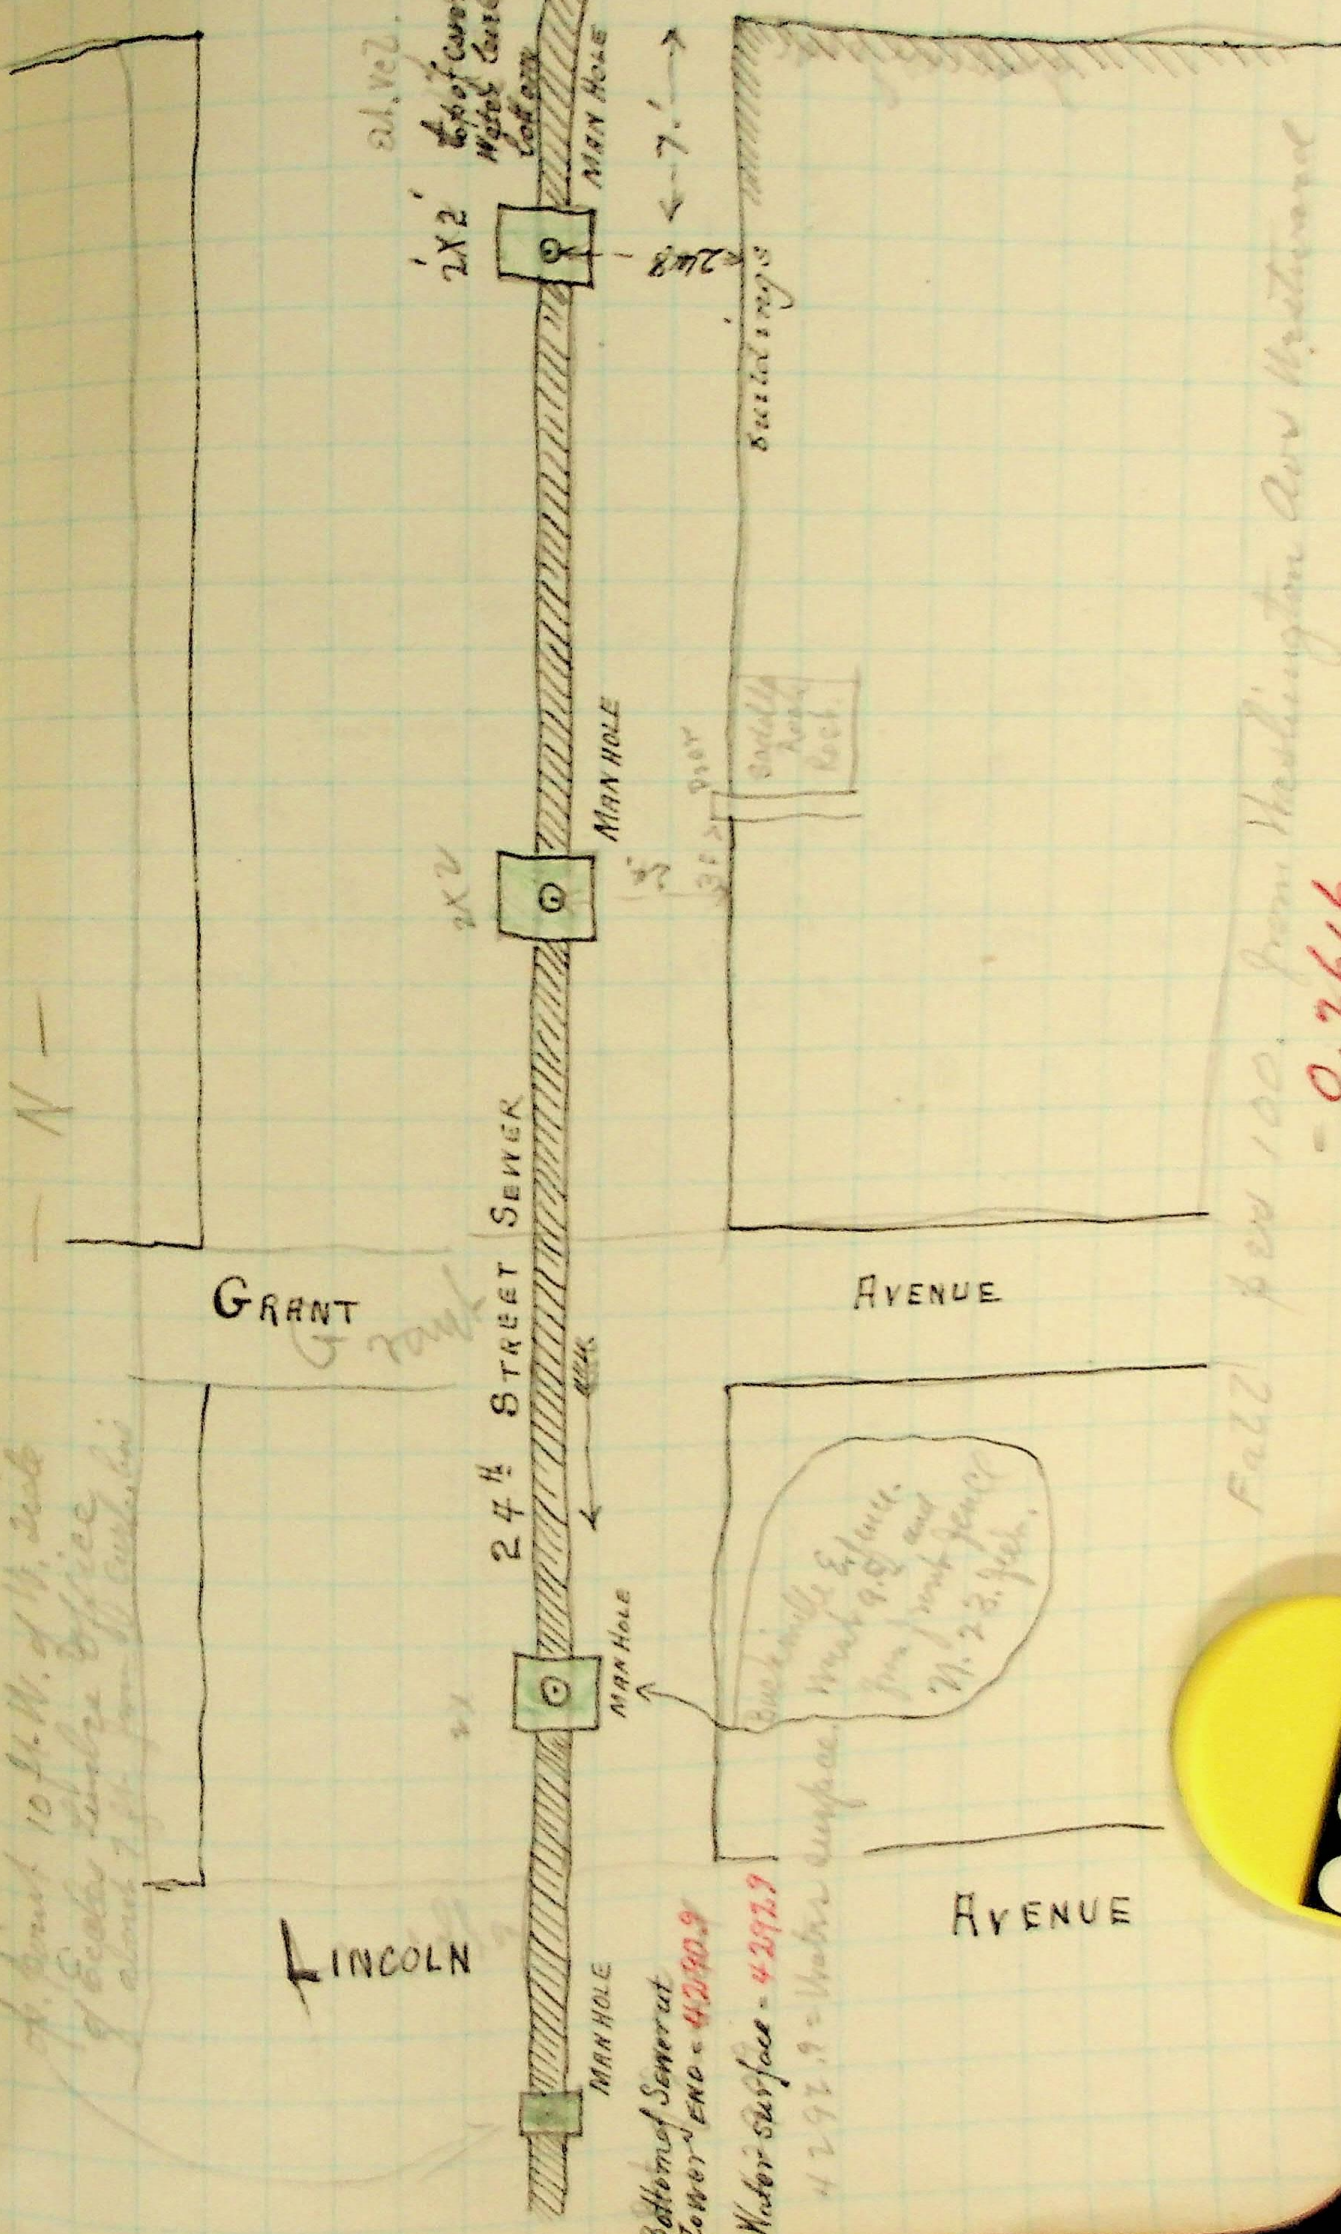

at point 10 ft. N. of W. side
of Ecology Centre Office
about 7 ft. from W. curb. (L)

Fall per 100. from Washington Ave Westward
- 0.2616

Bottom of Sewer at
Lower END = 4290.9
Water Surface = 4292.9

Buckville Engine.
Work 9.5'
from front fence
W. 23. feet.

