


FIVE

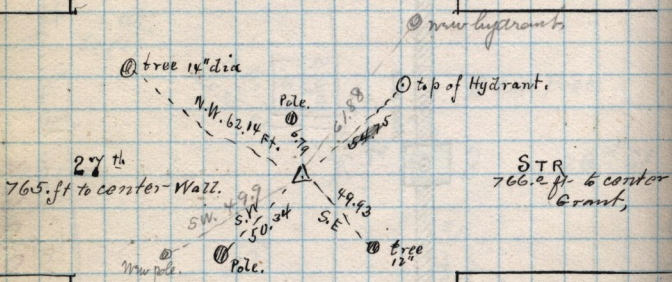

764.5 to center 28^A

LINCOLN