


Ave.

24<sup>th</sup>

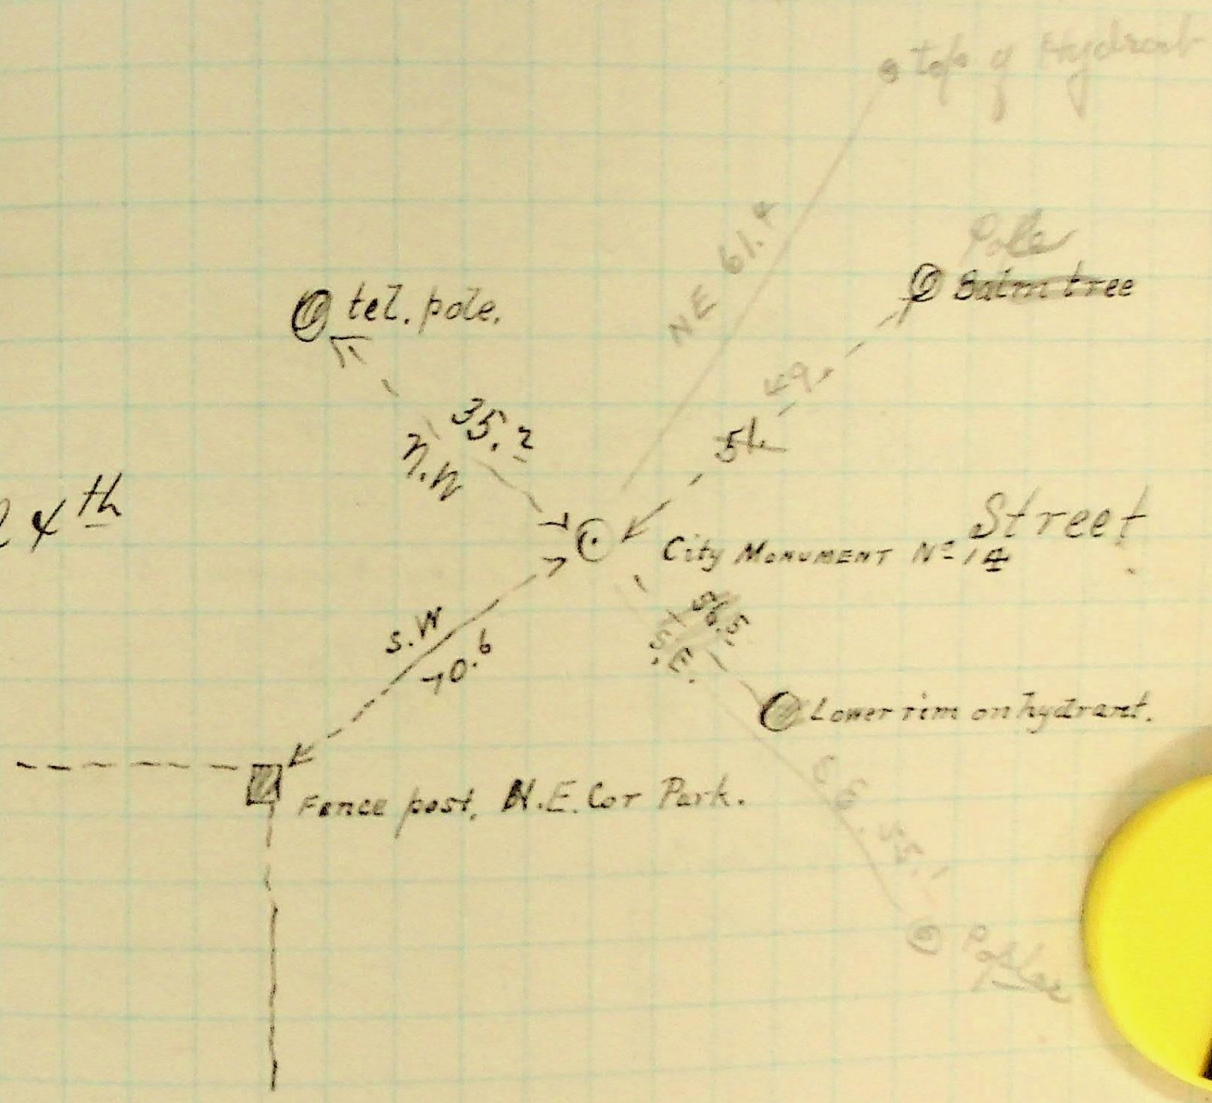

MADISON