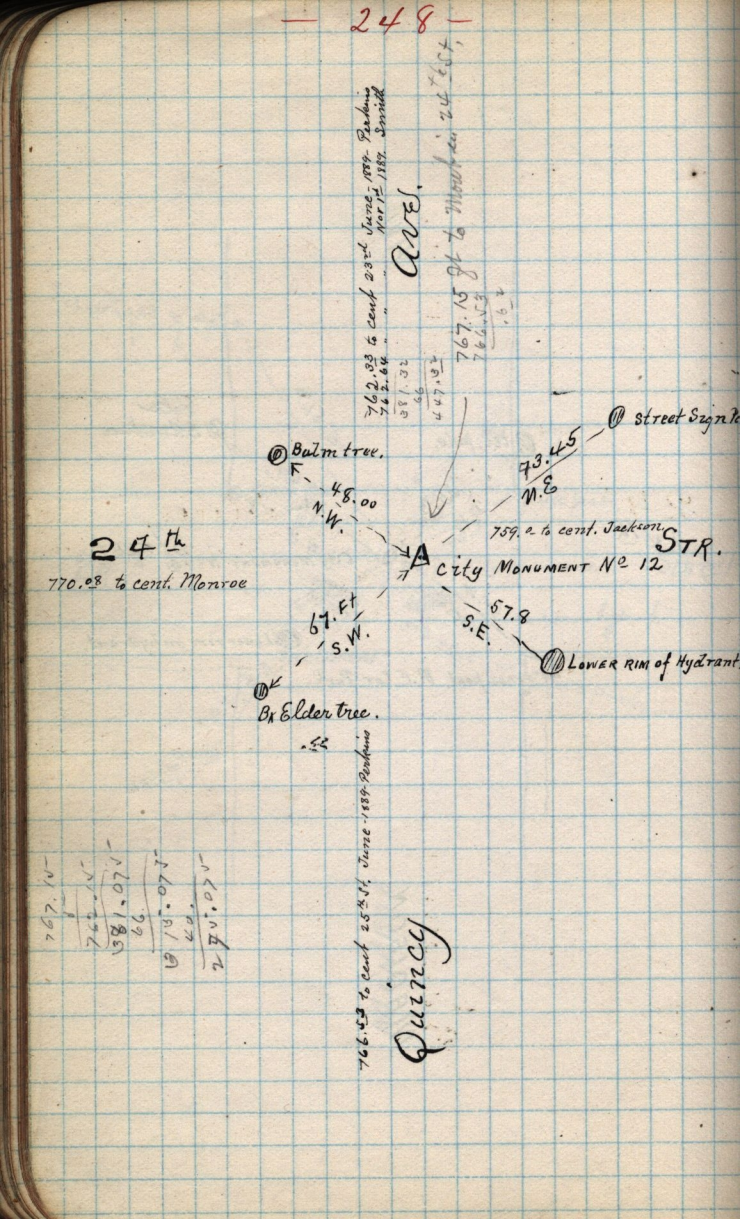

Ave.
762.33 to cent 23rd June - 1889 - Perkins
762.64 " " " Nov 1st 1889 Smith
381.32
66
447.32
767.15 ft to Monroe in 24th St.
766.53
.62
Street Sign No
73.45
N.E
Balm tree.
48.00
N.W.
759.0 to cent. Jackson
STR.
24th
770.08 to cent. Monroe
City Monument No 12
67.Ft
S.W.
57.8
S.E.
Lower Rim of Hydrant
Bx Elder tree.
766.53 to cent 25th St. June - 1889 - Perkins
Quincy
767.15
8
762.15
381.07
66
18.07
40.
275.07