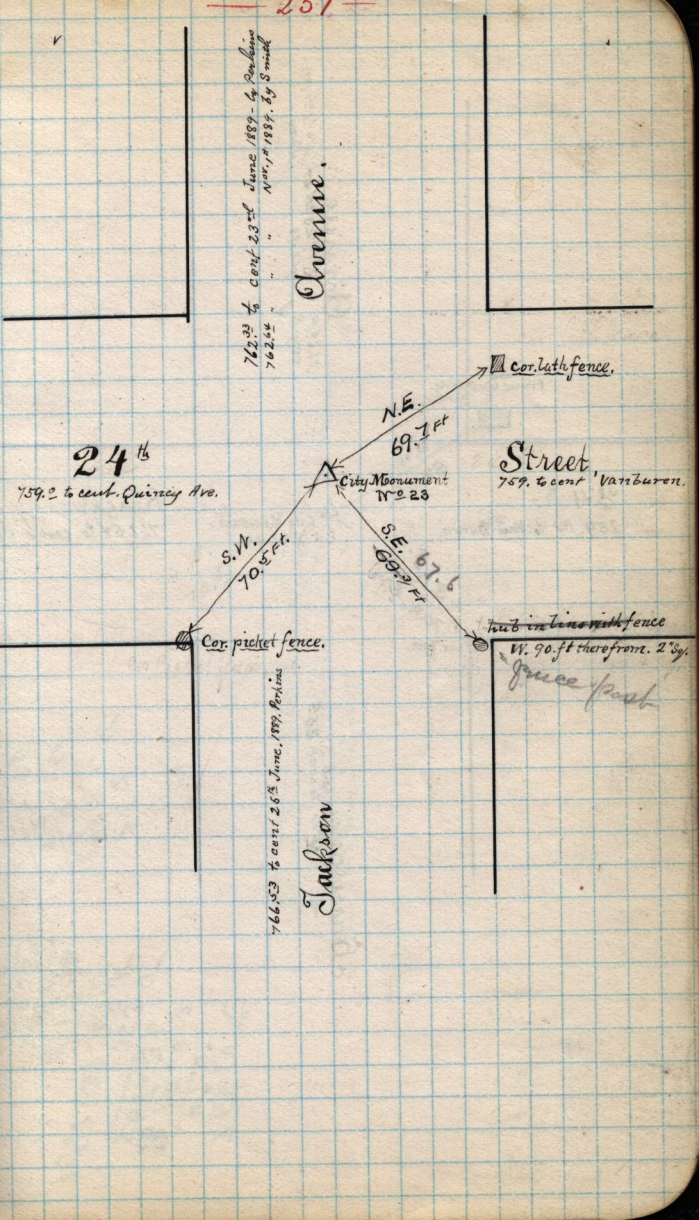
762.33 ft cent. 23rd June 1899 — G. Perkins
762.4 " " Nov.r 1894 — by Smith
Avenue.
24th
759.2 to cent. Quincy Ave.
cor. lath fence.
N.E.
69.7 Ft
Street
759. to cent. Vanburen.
City Monument
No 23
S.W.
70.5 Ft.
S.E. 67.6
Cor. picket fence.
nail in line with fence
W. 90. ft therefrom. 2" Sq.
Juice Post
764.93 ft cent 26th June, 1899 G. Perkins
Jackson