


Washington Ave.

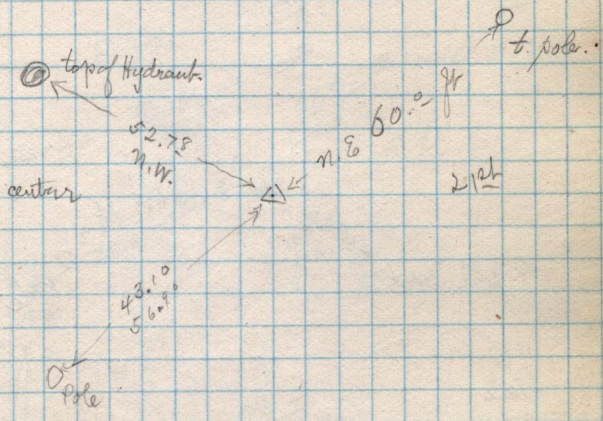

990.
20
970.

10 ft offset in