



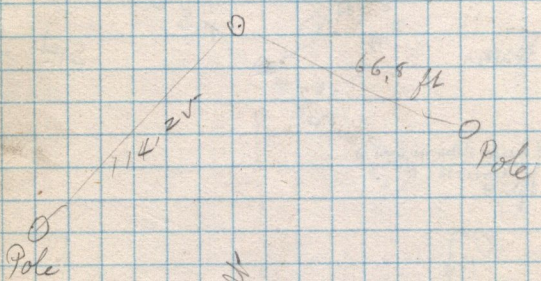

to center 2 1/4 . 970. ft