


QWB

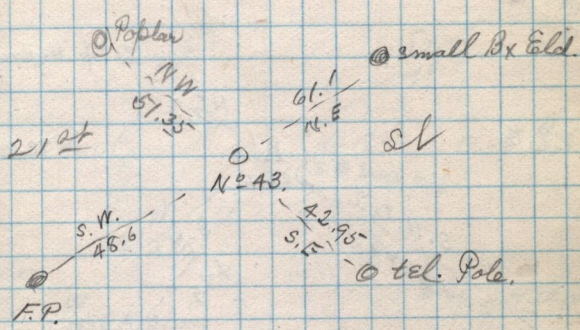

LIBERTY SQUARE.

Morse