


Wall Ave.

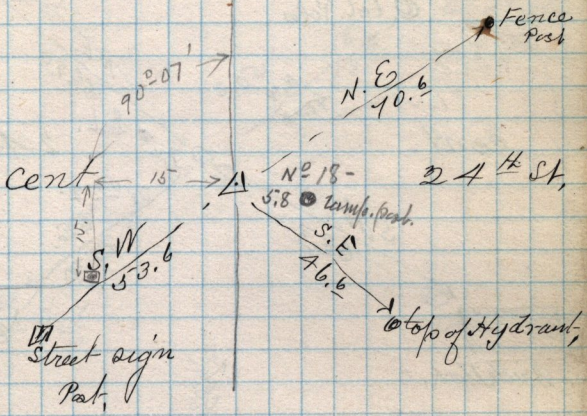

cent